

SITE PLAN CHECKLIST

- LEGAL DESCRIPTION.  
LOT 4, BLOCK 6, BAKKER LANDING 1ST ADDITION TO THE CITY OF TEA,  
LINCOLN COUNTY, SOUTH DAKOTA.
- ADDRESS(ES) KNOWN.  
2030 MERCHANT STREET, TEA, SD 57064
- NAME OF THE PROJECT/BUSINESS.  
CRIBS WAREHOUSE
- SCALE AND NORTH ARROW.  
AS SHOWN ON PLANS.
- PROPERTY LINES WITH DIMENSIONS AND PROPERTY AREA.  
AS SHOWN ON PLANS. AREA = 1.92 ACRES OR 83,451.0 SF MORE OR  
LESS.
- ALL EXISTING AND PROPOSED BUILDINGS, ADDITIONS, AND CHANGES IN USE, SHOW  
ALL DIMENSIONS AND GROSS FLOOR AREA FOR EACH USE (INCLUDE MEZZANINES).  
AS SHOWN ON PLANS. SEE ARCHITECTURAL PLANS.
- MANUFACTURING/WHOLESALE/WAREHOUSE - # EMPLOYEES ON MAXIMUM SHIFT:  
N/A
- BUILDING HEIGHT AND NUMBER OF STORIES.  
SEE ARCHITECTURAL PLANS.
- ALL PROTRUSIONS (BALCONIES, FIREPLACES, AIR CONDITIONERS, VESTIBULES,  
OVERHANGS, ETC.).  
AS SHOWN ON PLANS.
- ALL EASEMENTS.  
AS SHOWN ON PLANS.
- FIRST FLOOR ELEVATIONS (SHOWN FLOODPLAIN AND OR FLOODWAY LINE IF  
APPLICABLE).  
AS SHOWN ON PLANS.  
SITE SUBJECT PROPERTIES FLOOD ZONE PER FEMA FLOOD  
INSURANCE RATE MAP COMMUNITY FLOOD INSURANCE RATE MAP NO. 15083C0133C,  
DATED APRIL 2, 2008. SITE IS LOCATED IN ZONE X.  
MINIMAL FLOOD HAZARD. SEE SPECIFIC MAP FOR DETAILS.  
REGARDING LIMITS OF ZONES.
- DISTANCE FROM ALL BUILDINGS AND PARKING LOT BORDERS TO PROPERTY  
LINES AT THE CLOSEST POINTS.  
AS SHOWN ON PLANS.
- PARKING LOT: DESIGNATE EACH SPACE (DIMENSIONS OF LOT, STALLS, AND AISLES).  
THE PROPOSED PARKING LOT SURFACE, HANDICAP ACCESSIBLE AND COMPACT  
SPACES (AND SHOW THE LOCATION OF SIGNAGE FOR BOTH), CURB/BUMPER BLOCKS,  
AND STAKING SPACES (IF REQUIRED FOR DRIVE-UP WINDOW/DEVICE).  
# OF REGULAR STALLS - 13 STALLS  
# OF ACCESSIBLE STALLS - 1 STALL  
# OF TOTAL STALLS PROVIDED = 14
- LOADING SPACE(S): SHOW LOCATION AND SIZE (14' X 35' IS REQUIRED).  
N/A
- PARKING LOT SCREENING: SHOW HEIGHT, LOCATION, AND TYPE OF MATERIAL TO  
BE USED.  
N/A
- TRASH CONTAINER AREA(S) THAT ARE LOCATED OUTSIDE OF BUILDINGS AND  
SCREENED HEIGHT AND MATERIAL.  
AS SHOWN ON PLANS.
- DESCRIBE THE USES OF ALL ADJACENT PROPERTY, INCLUDING ACROSS THE  
STREET OR ALLEY.  
NORTH: I-1 - LIGHT INDUSTRIAL  
SOUTH: I-1 - LIGHT INDUSTRIAL  
EAST: I-1 - LIGHT INDUSTRIAL  
WEST: I-1 - LIGHT INDUSTRIAL  
SUBJECT PROPERTY ZONE: I-1 - LIGHT INDUSTRIAL
- CURB CUT(S) AND PUBLIC SIDEWALK (EXISTING AND PROPOSED).  
AS SHOWN ON PLANS.
- IF OUTSIDE LIGHTING IS PROPOSED, PROVIDE A PHOTOMETRIC PLAN TOGETHER  
WITH A CATALOG CUT SHEET (PICTURE) SHOWING EACH TYPE OF FIXTURE, THE LUMENS  
(OR WATTAGE) AND HEIGHT OF POLE MOUNTED FIXTURES ABOVE THE PARKING LOT  
SURFACE. PHOTOMETRIC NOT REQUIRED IF NO LIGHTED CANOPY AND THE PROPERTY IS  
NOT ADJACENT TO RESIDENTIALLY USED OR ZONED PROPERTY.  
N/A
- NAMES AND LOCATIONS OF ALL ADJACENT STREETS, ALLEYS, WATERWAYS, OR  
OTHER PUBLIC WAYS.  
AS SHOWN ON PLANS.
- EITHER SUPPLY A SEPARATE LANDSCAPE PLAN OR DESCRIBE THE LOCATION, TYPE,  
AND SIZE OF MATERIALS ON THE SITE PLAN. DESCRIBE THE GROUND COVER IN THE  
REQUIRED FRONT YARD SETBACK.  
LANDSCAPING AS SHOWN ON PLANS (TO RIGHT).  
THE SITE WILL BE SEEDED, MULCHED, AND FERTILIZED  
POST-CONSTRUCTION.
- PROPOSED TOPOGRAPHY.  
SEE GRADING PLAN ON SHEET C105.
- ALL THE PUBLIC AND PRIVATE UTILITIES ON THE PROPERTY AND ADJACENT PUBLIC  
PROPERTY.  
AS SHOWN ON PLANS.
- OWNER NAME AND ADDRESS.  
CRIBS, LLC  
PO BOX 459  
TEA, SD 57064
- DEVELOPER NAME, ADDRESS, AND PHONE NUMBER.  
JAVERS CONSTRUCTION  
PO BOX 459,  
TEA, SD 57064  
PROJECT MANAGER: CHAD JAVERS  
EMAIL ADDRESS: chad@javersconstruction.com  
PHONE NUMBER: 605-940-1800

TREE SPECIES CONFLICTS  
W/ POWER LINE CLEAR. —  
USE LOW-GROWTH TYPE


TREE 8' FROM UTIL.  
EASEMENT — VERIFY  
MIN. SETBACK REQ'D

IRRIGATION COVERAGE  
MISSING AT E CORNER —  
ADD ZONE OR HEADS

SHRUB SPACING 8' O.C.  
NON-STANDARD — LOCAL  
CODE REQ'S 5' MAX

GROUND COVER TYPE  
NOT SPECIFIED AT  
BORE HOLE LOCATION AREA

??

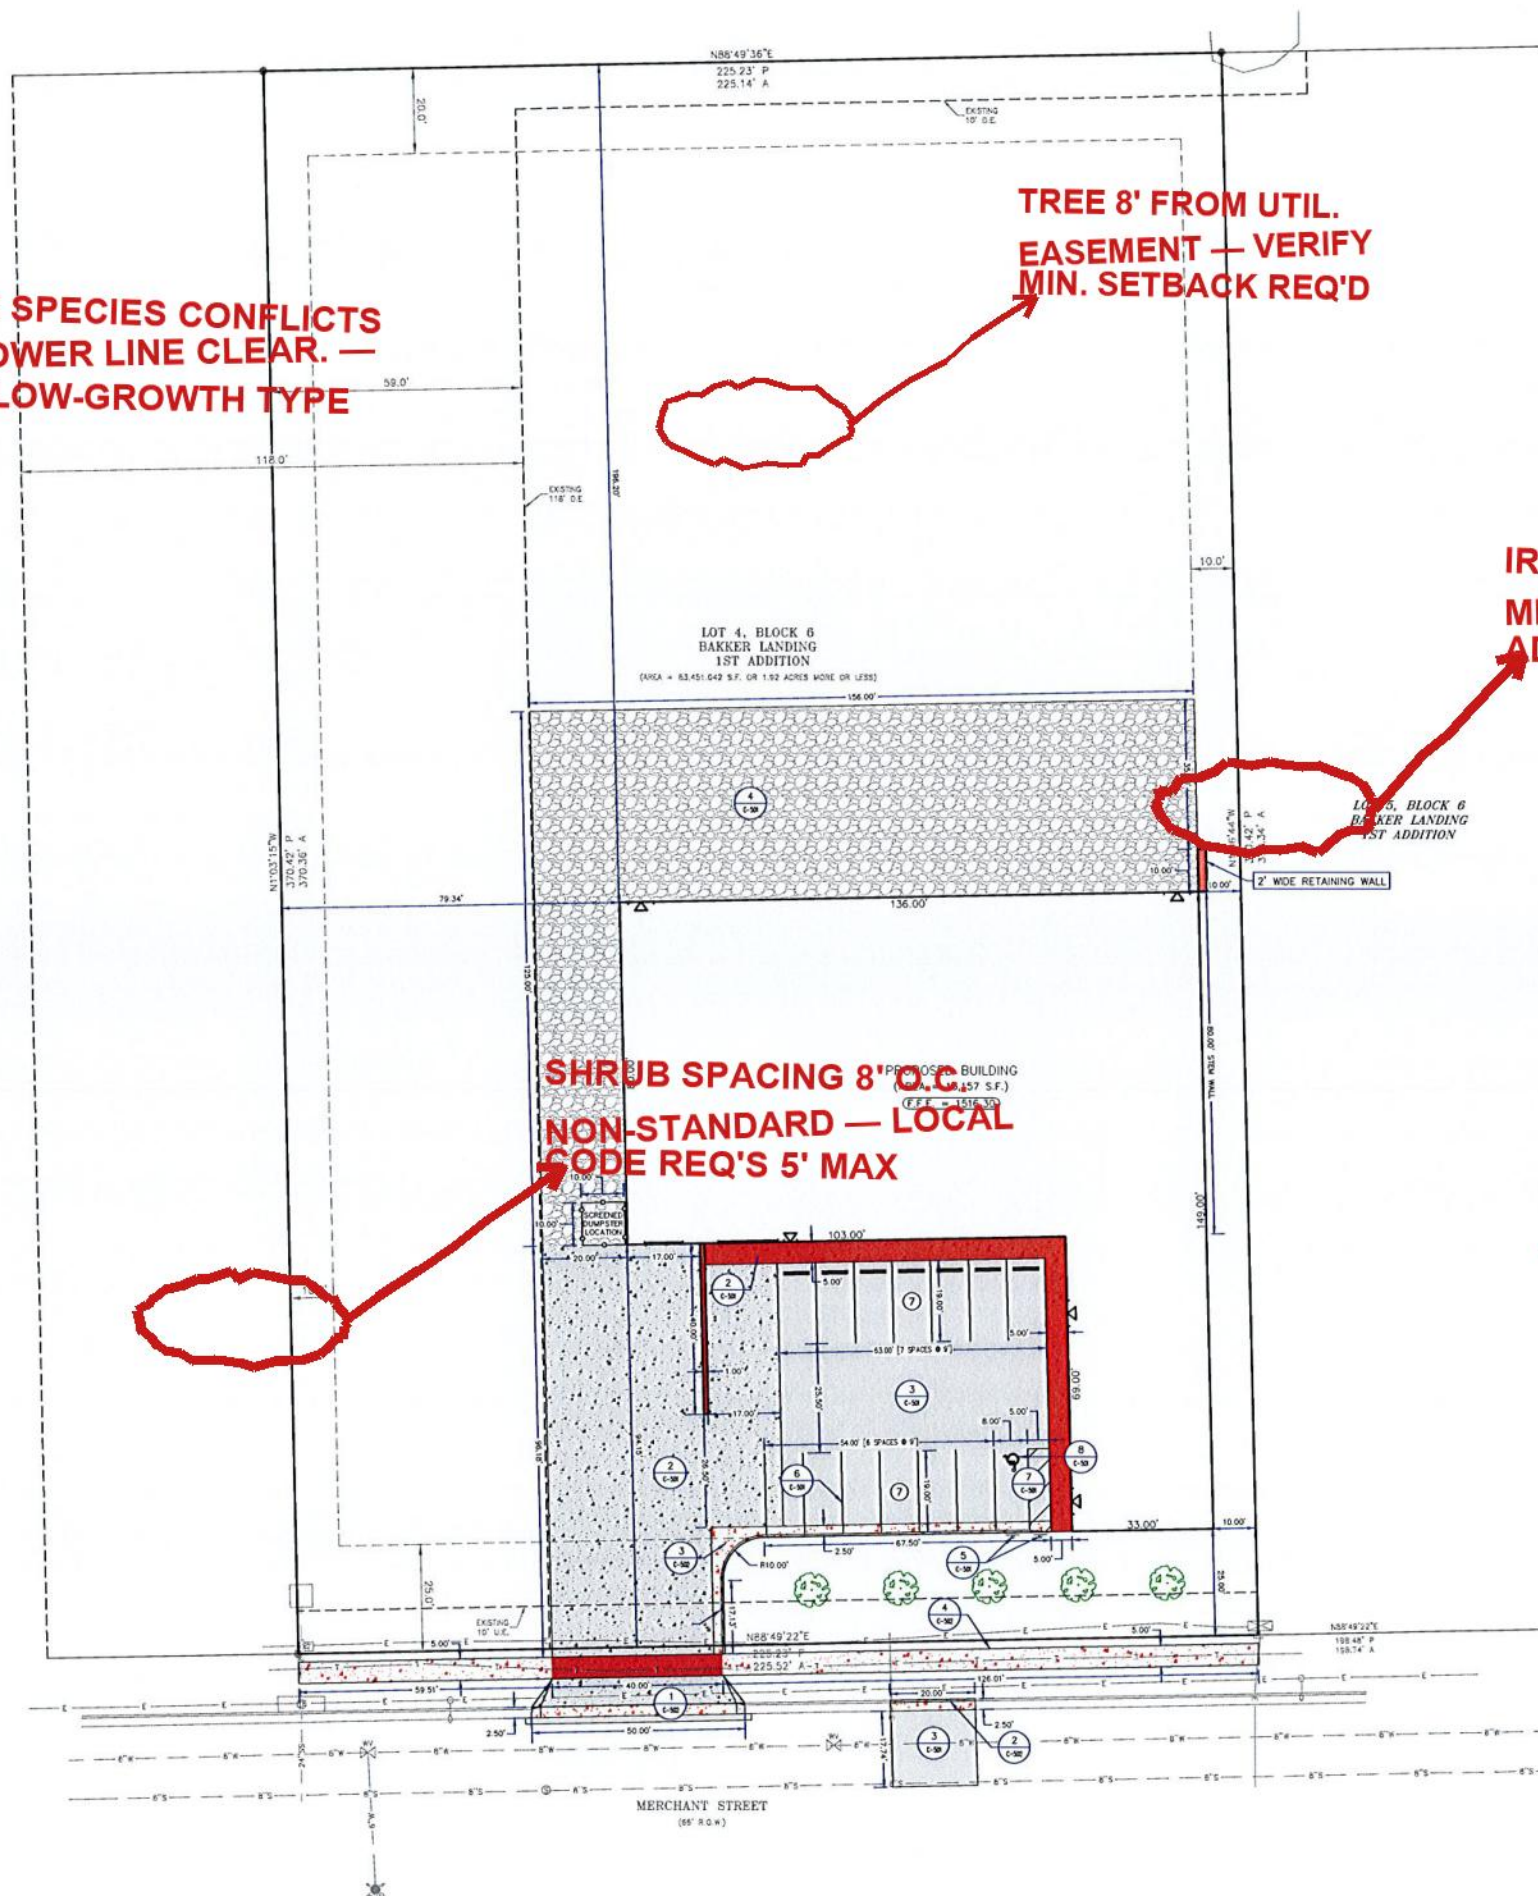

LEGEND

- EXISTING LOT LINE
- PROPOSED LOT LINE
- SETBACK
- EXISTING EASEMENT
- PROPOSED P.C.C. VALLEY GUTTER AND CURB & GUTTER
- PROPOSED 4" P.C.C. SIDEWALK
- PROPOSED 6" P.C.C. SIDEWALK
- PROPOSED LIGHT DUTY ASPHALT SECTION
- PROPOSED LIGHT DUTY CONCRETE SECTION
- PROPOSED ASPHALT SECTION
- TIP GUTTER OUT
- CRUPPED CURB (1/4" R)

GENERAL NOTES

- IMPORTANT: THE CIVIL AND ARCHITECTURAL SITE PLANS REFLECT THE DESIGN INTENT FOR THE SITE AND SHOULD NOT HAVE ANY MATERIAL DISCREPANCIES. REPORT ANY DISCREPANCIES TO THE ARCHITECT AND THE CIVIL ENGINEER IMMEDIATELY. THE CIVIL SITE PLAN SHEET WILL CONTAIN THE DIMENSIONING, SLOPING & GRADING, SPOT ELEVATIONS, & OTHER REQUIREMENTS.
- CONTRACTOR TO VERIFY ALL EXISTING SITE CONDITIONS PRIOR TO SITE PREPARATION. REPORT ANY DISCREPANCIES TO ARCHITECT AND CIVIL ENGINEER IMMEDIATELY.
- CONTRACTOR TO VERIFY ANY CRITICAL DIMENSIONS WITH REGARDS TO EXISTING CONSTRUCTION, IF ANY.
- ALL DIMENSIONS ARE TO THE BACK OF CURB (WHERE APPLICABLE) UNLESS NOTED OTHERWISE.
- PROVIDE A 1/2-IN EXPANSION JOINT BETWEEN ALL CONCRETE PAVEMENTS AND THE BUILDING AND ALL OTHER STRUCTURES OR INTRUSIONS. REFER TO DETAIL 1/C501 FOR CONCRETE PAVEMENT JOINTING PLANS.
- THE DEVELOPMENT PLANS HAVE BEEN REVIEWED WITH THE PREPARATION OF THIS SITE PLAN.

STREET TREES

MERCHANT STREET FRONTAGE:  
1 TREE / 50' FRONTAGE = 226' / 50' = 5 TREES  
TOTAL TREES REQUIRED = 5 (PROVIDED = 5)  
STREET TREES SHALL BE A MINIMUM OF 2 IN CALIPER AND SPACING SHALL BE A MINIMUM OF 14 IN CALIPER. TREES SHALL BE A MIX OF APPROVED SPECIES. CONTACT THE CITY OF SIOUX FALLS FORESTRY OFFICE FOR A LIST OF APPROVED VARIETIES (605-367-8150).  
MINIMUM NUMBER OF TREE SPECIES = 2  
FINAL TREE LOCATION TO BE DETERMINED UPON CONSTRUCTION.  
SPECIES:  
1. SUGAR MAPLE  
2. BLACK MAPLE

|                                                                                                |                                |
|------------------------------------------------------------------------------------------------|--------------------------------|
| PROJECT NO.<br>SD231009                                                                        |                                |
| REVISIONS                                                                                      | BY<br>DATE<br>DESCRIPTION      |
| NO.                                                                                            | 1<br>1/3/25<br>PER CITY REVIEW |
| EHRHART<br>GRIFFIN &<br>ASSOCIATES                                                             |                                |
| 601 N. Minnesota Ave.<br>Sioux Falls, So. Dak. 57104<br>P: 605 / 339-7215<br>F: 605 / 339-7271 |                                |
| • ENGINEERING<br>• PLANNING<br>• LAND SURVEYING                                                |                                |
| HOH WAREHOUSE<br>SITE & LANDSCAPING PLAN                                                       |                                |
| LOT 4, BLOCK 6, BAKKER LANDING 1ST ADDITION<br>TEA, SD 57064                                   |                                |
| DATE: 01/13/25<br>DESIGNED BY:<br>MAS<br>DRAWN BY:<br>MAS<br>CHECKED BY:<br>DFG<br>CREW: LRM   |                                |
| PROGRESS SET<br>NOT FOR<br>CONSTRUCTION                                                        |                                |
| SHEET NO.<br>C-104                                                                             |                                |