

REVIEW SET

REV. 1

ADD COUNTER
LENGTH DIM.

DR SWING BLOCKS
EGRESS CORR.
FLIP OR RECESSE

LAV. CFS = 28"
ADA MIN 30"
FIX LAYOUT

ADD WALL TYPE
CALLOUT

CONF.
12/0 X 16/0
192 SQ. FT.
2 WIN. HERE /
1 ON SHT 105 -
RECONCILE


PANEL CLRNC.
3'-6" MIN PER
NEC 110.26

VERIFY TOD < 200'
W/O SPRLR (IBC)

CLOSET 2'-0" DEEP
NOT FUNCTIONAL -
COORD. W/ OWNER

??

verify?

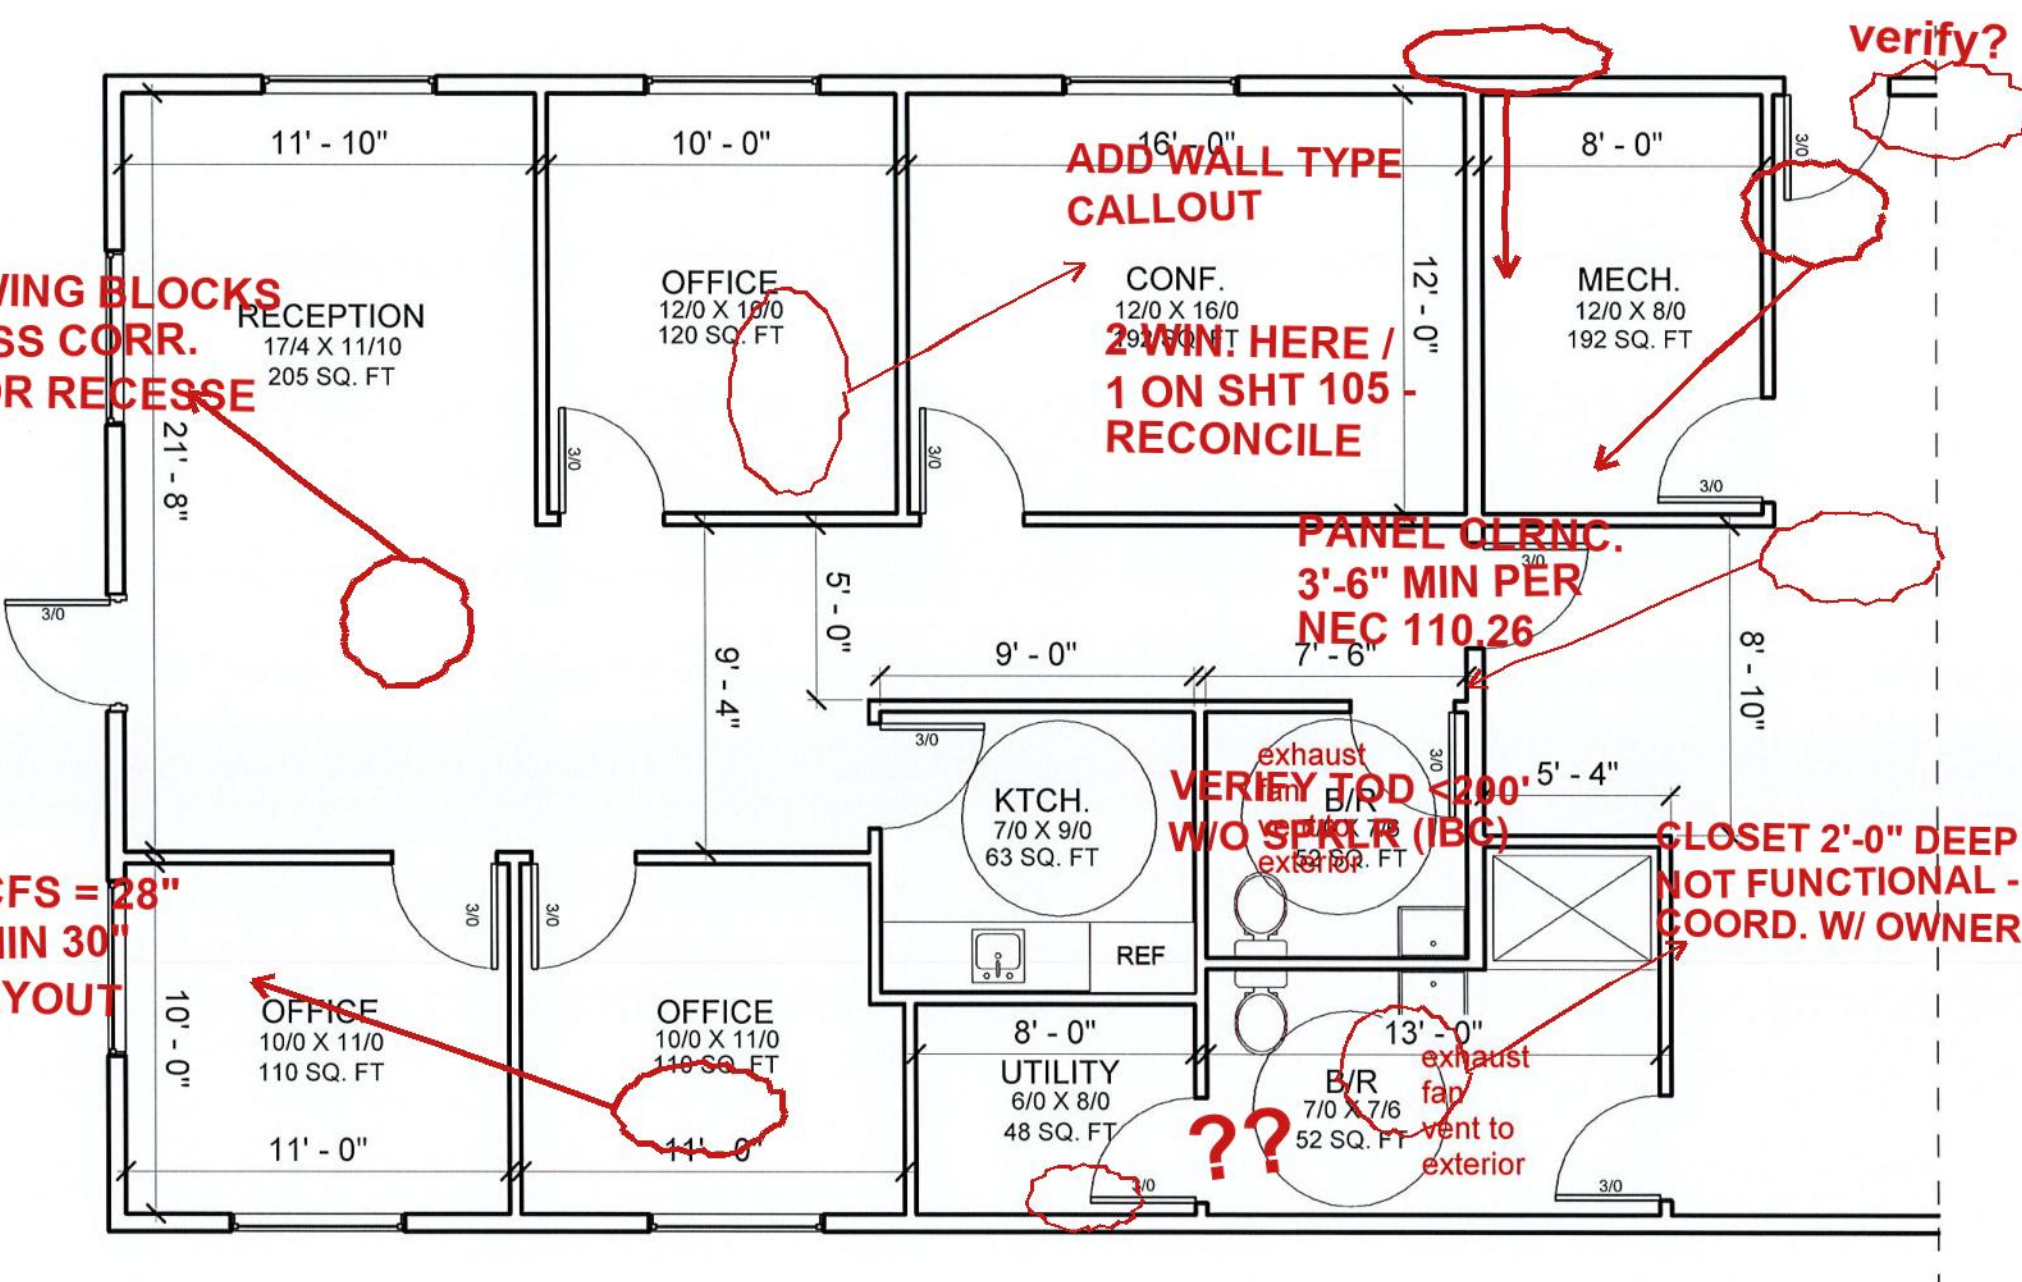

(605)-940-3802 JaversConstruction.com

HOH

Sq. Ft.	Area	Add.
1080	Office	

Office Floorplan

Project number N/A
Date N/A
Drawn by ICB
Checked by CGJ

103

Scale 3/16" = 1'-0"