






(605)-940-3802 JaversConstruction.com

HOH

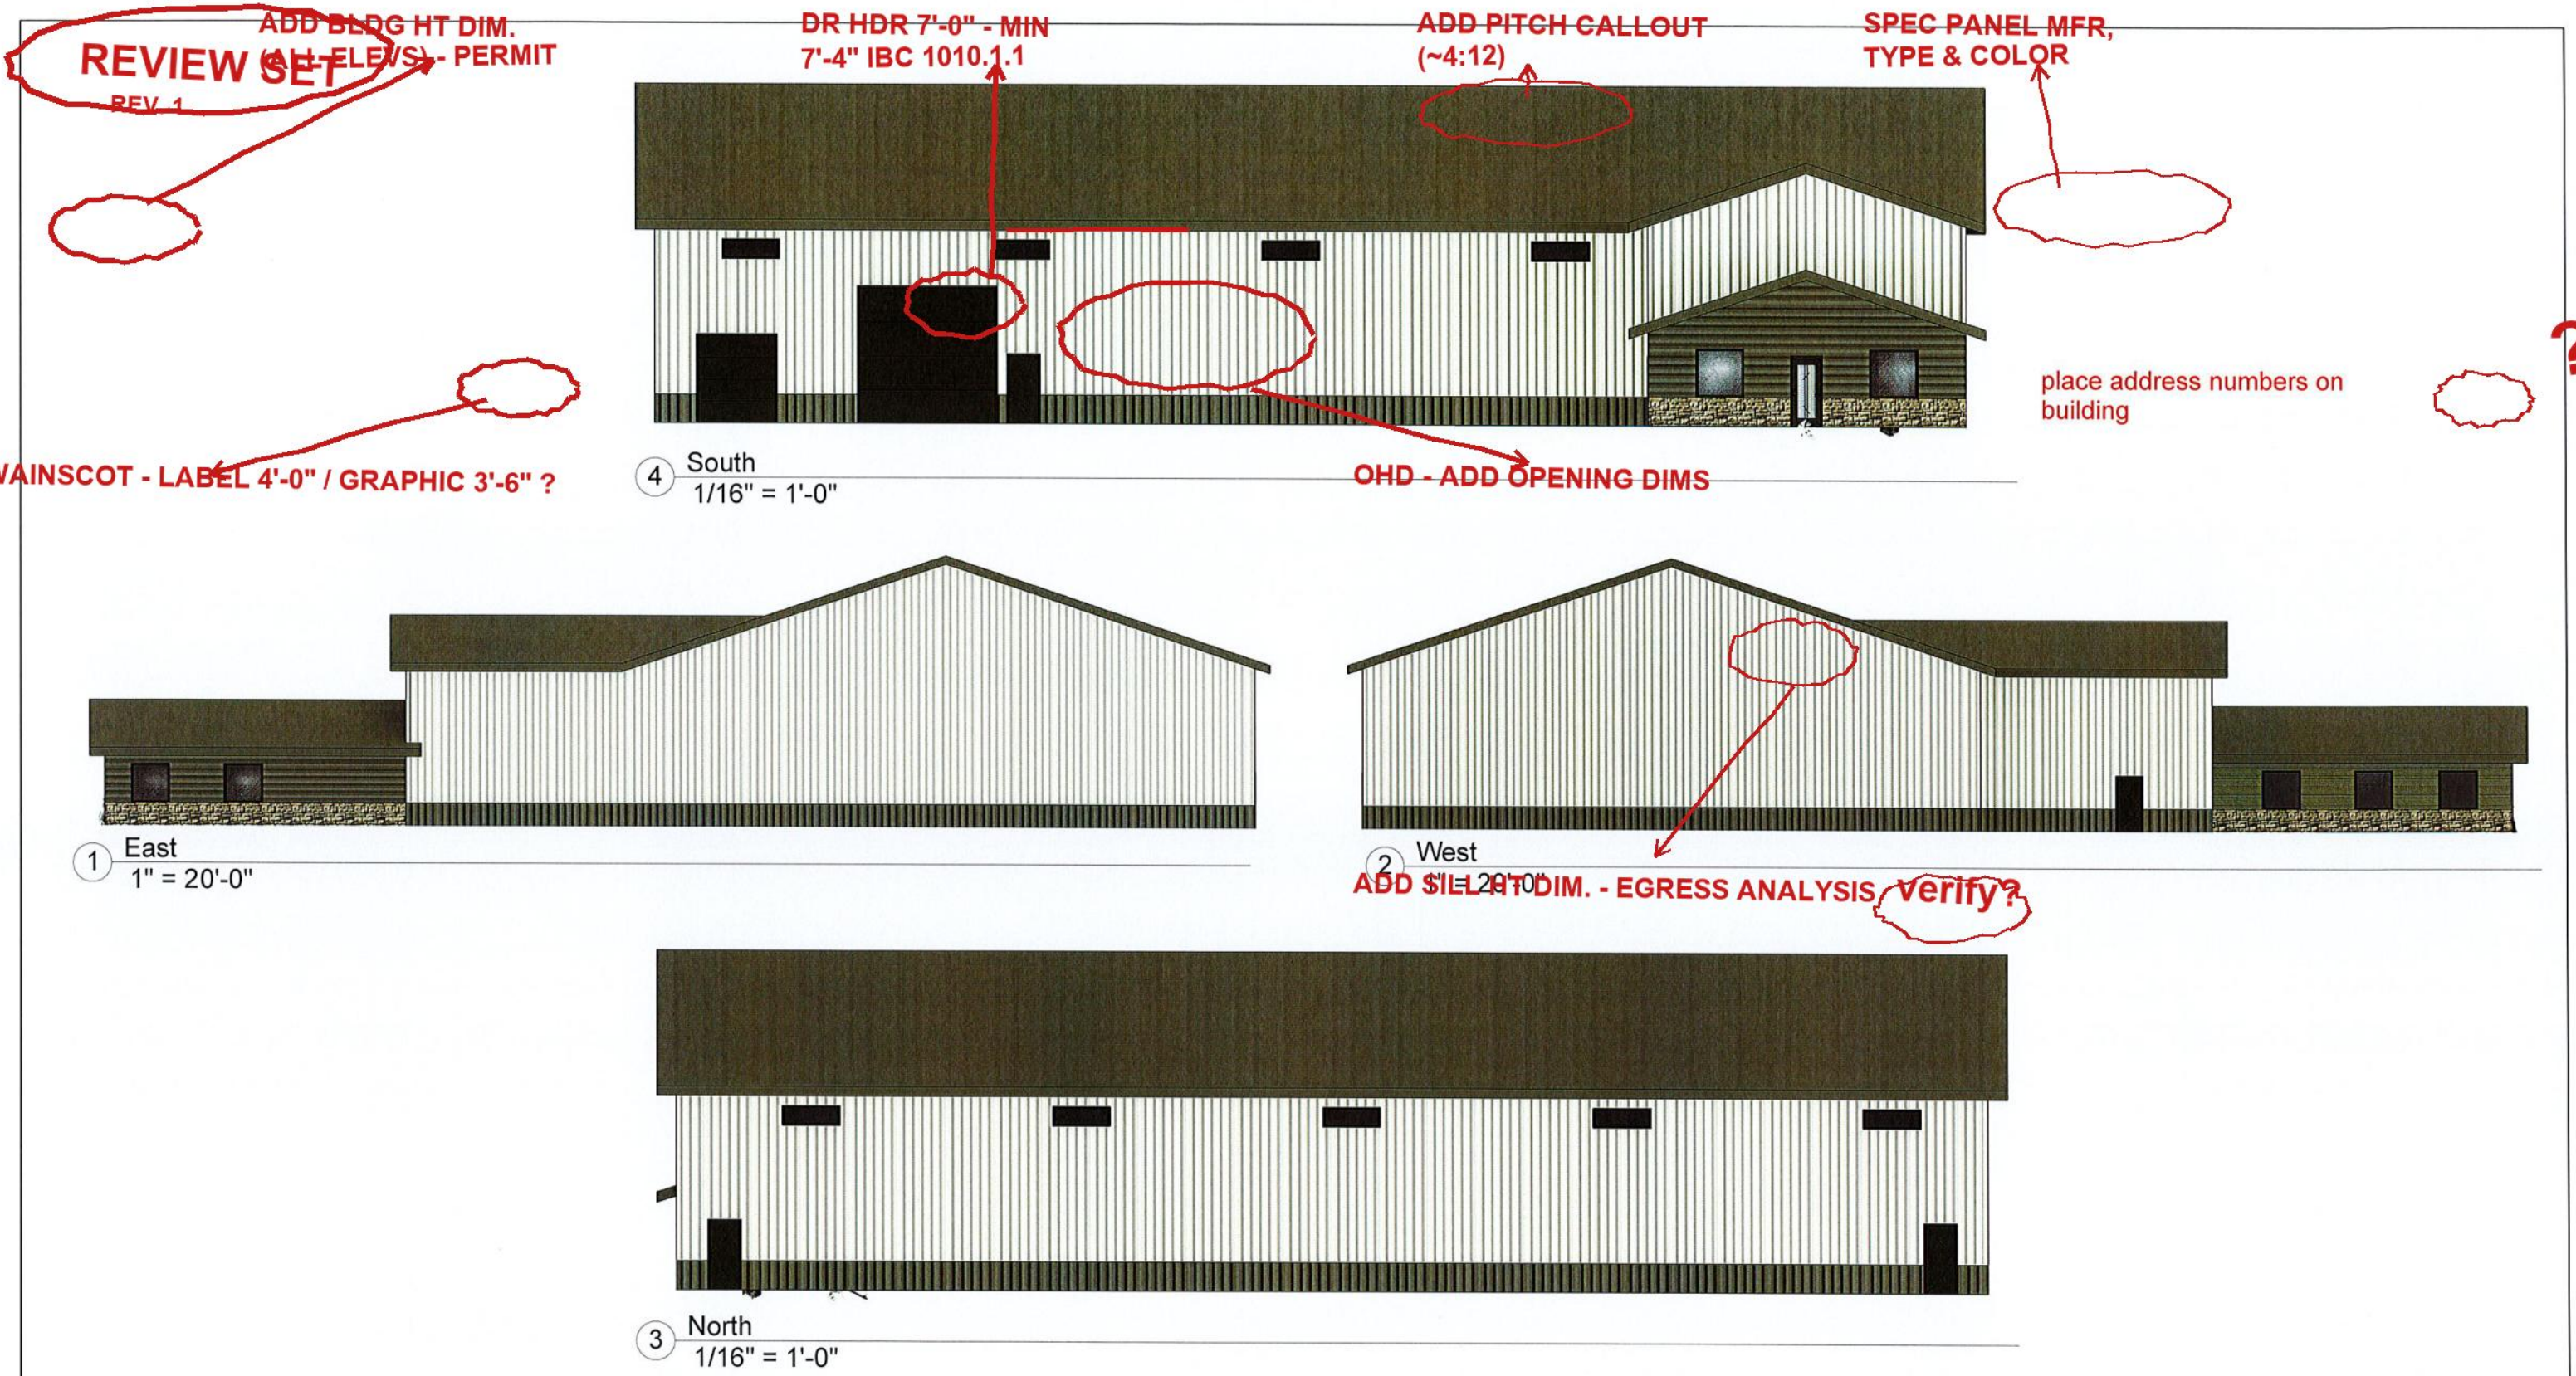

Sq. Ft.	Area	Add.

Elevations		
Project number	N/A	105
Date	N/A	
Drawn by	ICB	
Checked by	CGJ	
Scale As indicated		

FG LINE - VERIFY MATCHES C-401