 





TOVANI HART

609 A COLUMBIA ST. SW.
OLYMPIA, WA 98501
P 360.339.8274 • F
360.350.5614



SAN MARCOS FIRE DEPARTMENT
FIRE TRAINING CENTER






7410 State Highway 21
San Marcos, Texas 78666

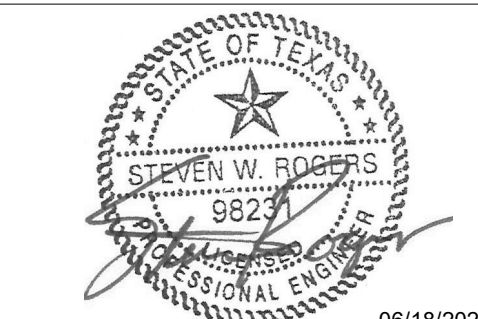

JOB NO.
2018-036
DRAWN BY
DJ
DATE
6/18/2021
REVISIONS
ADD. NO. 1 5/02/2022

PERMIT SET
FLOOR AND ROOF
FRAMING PLANS

S201

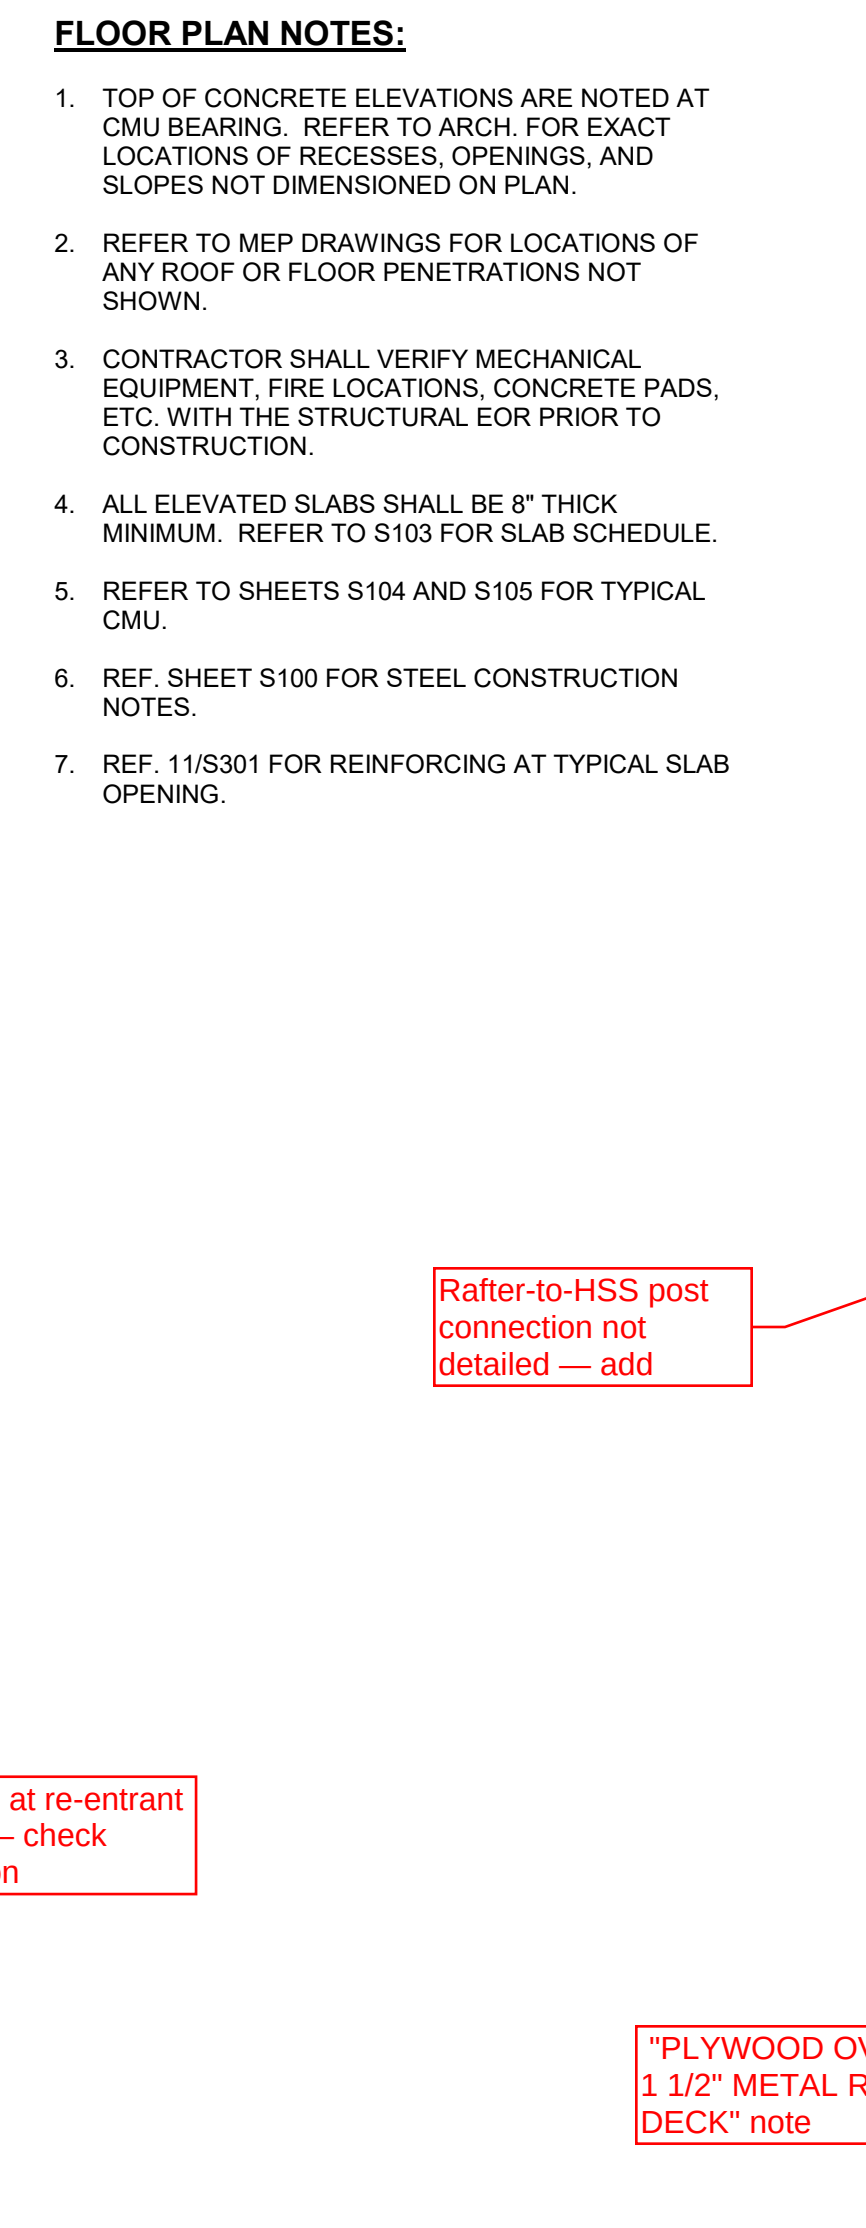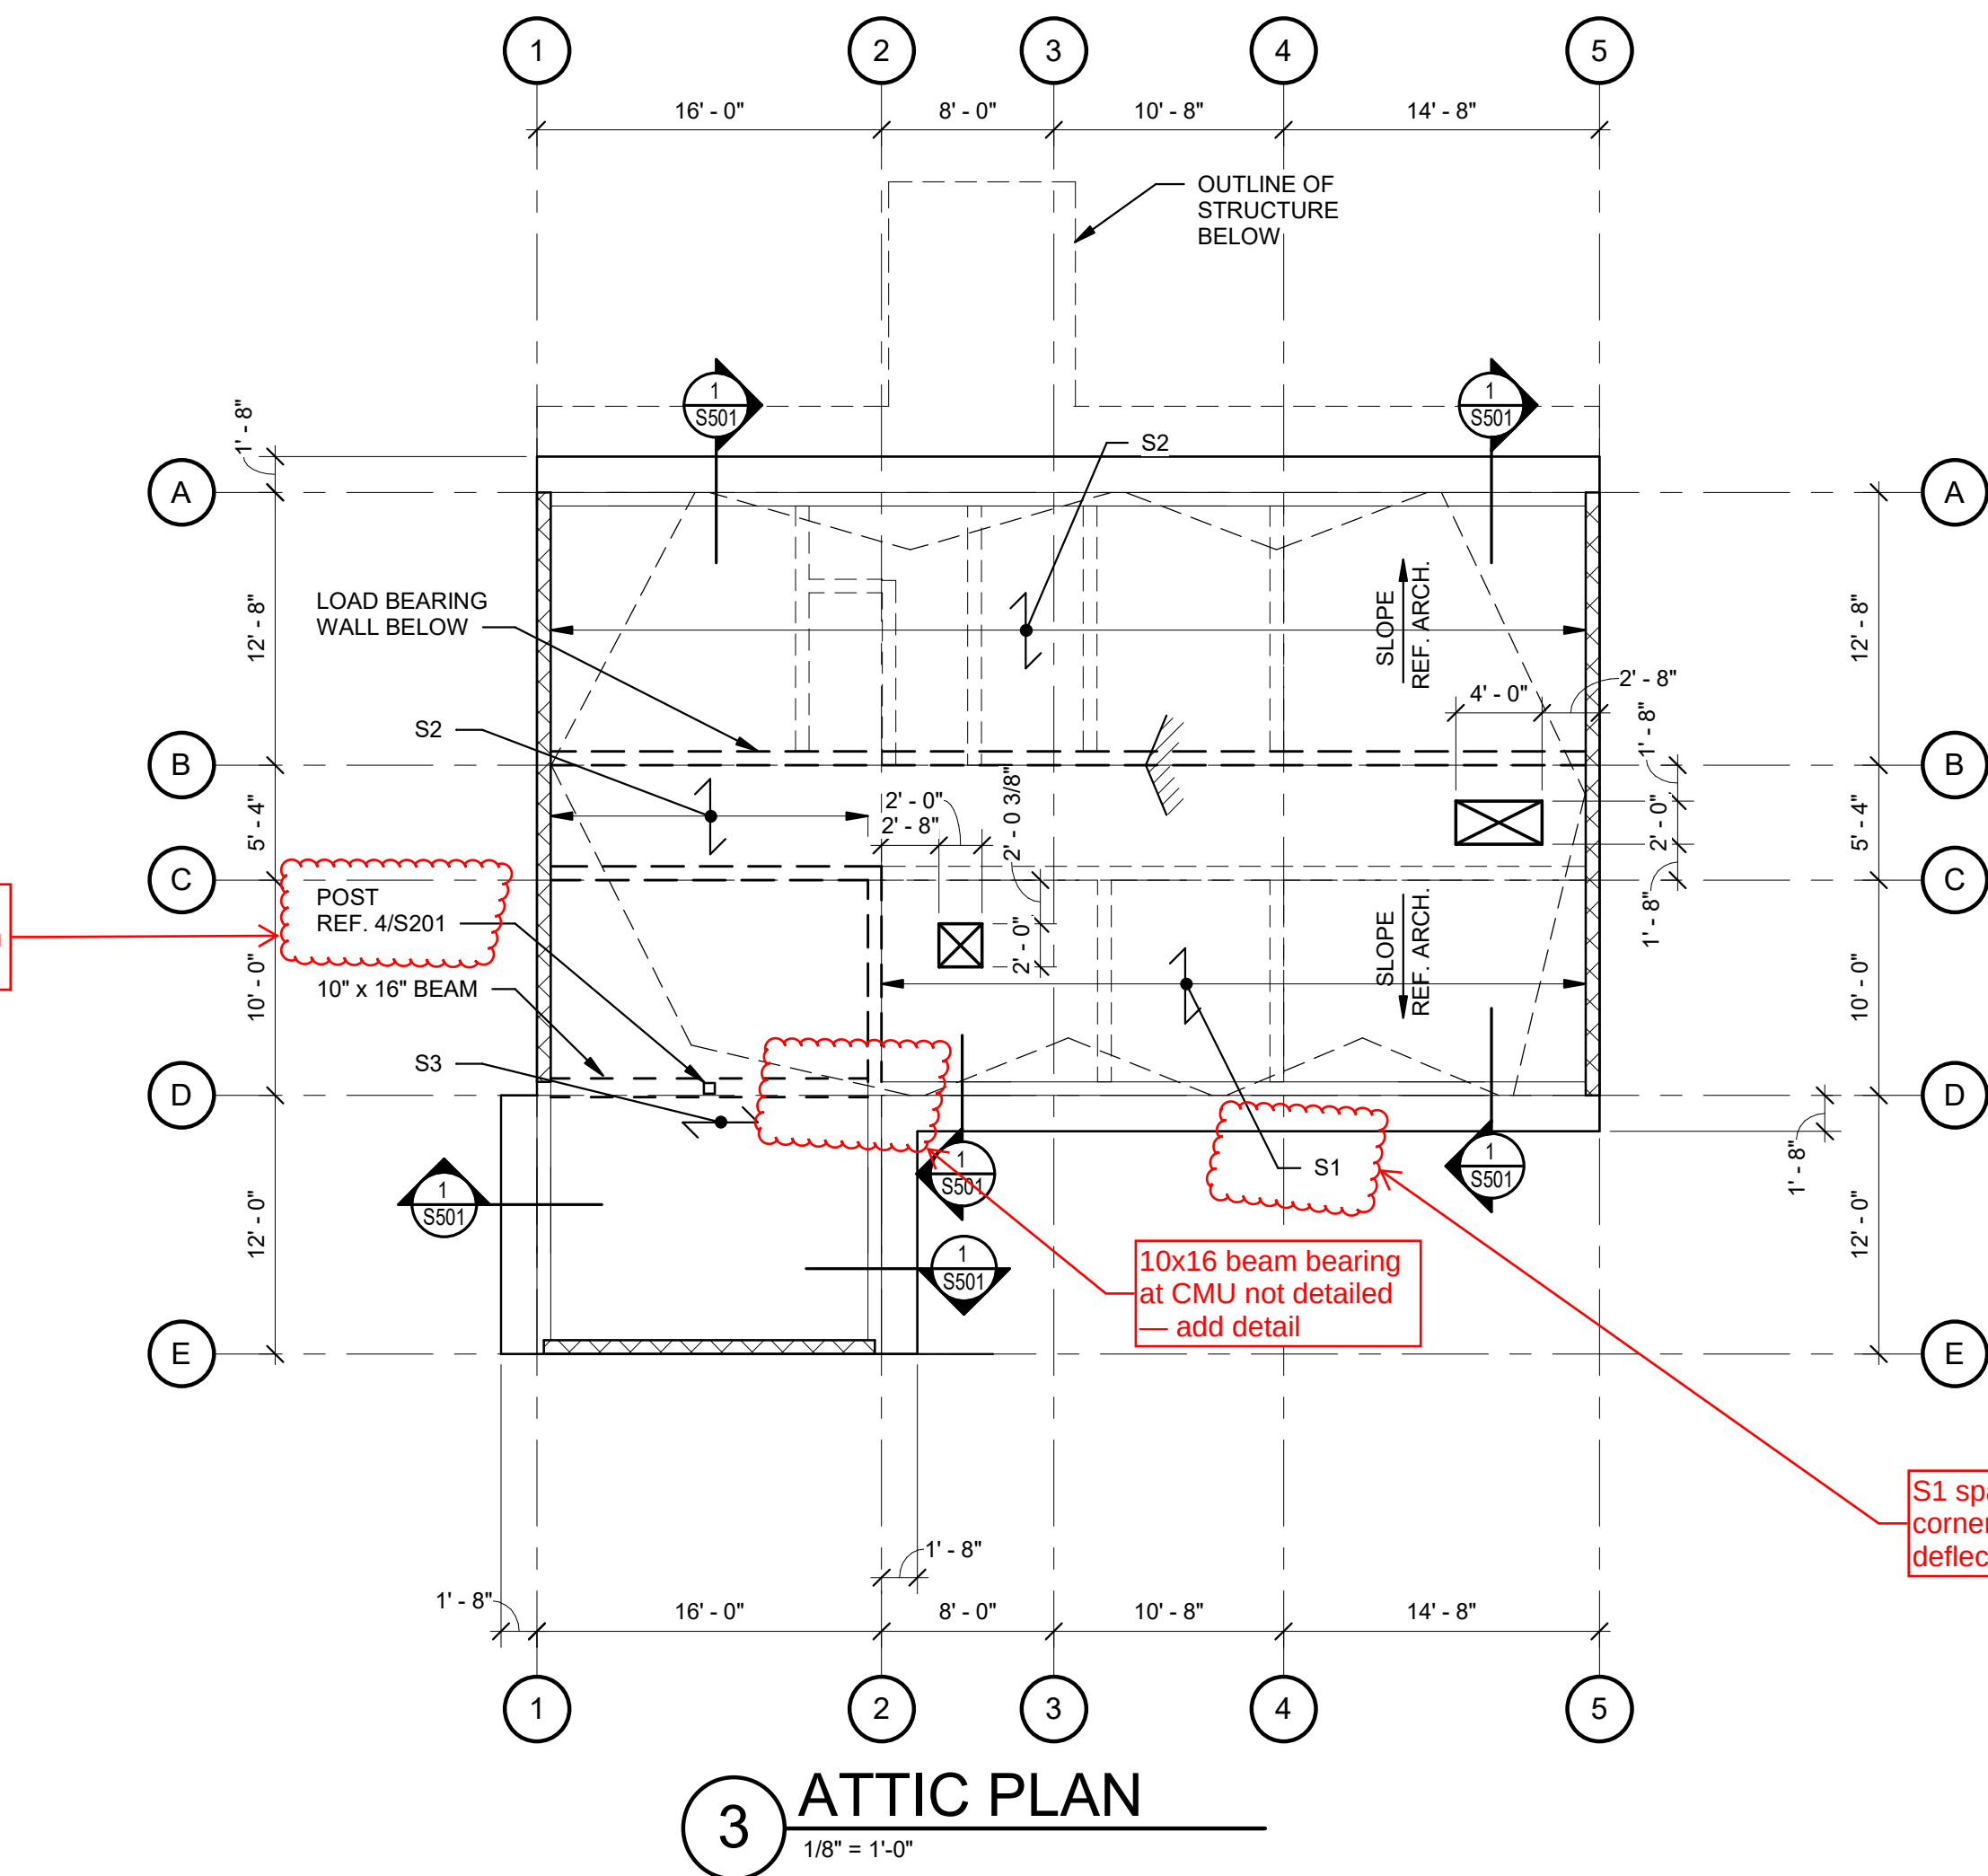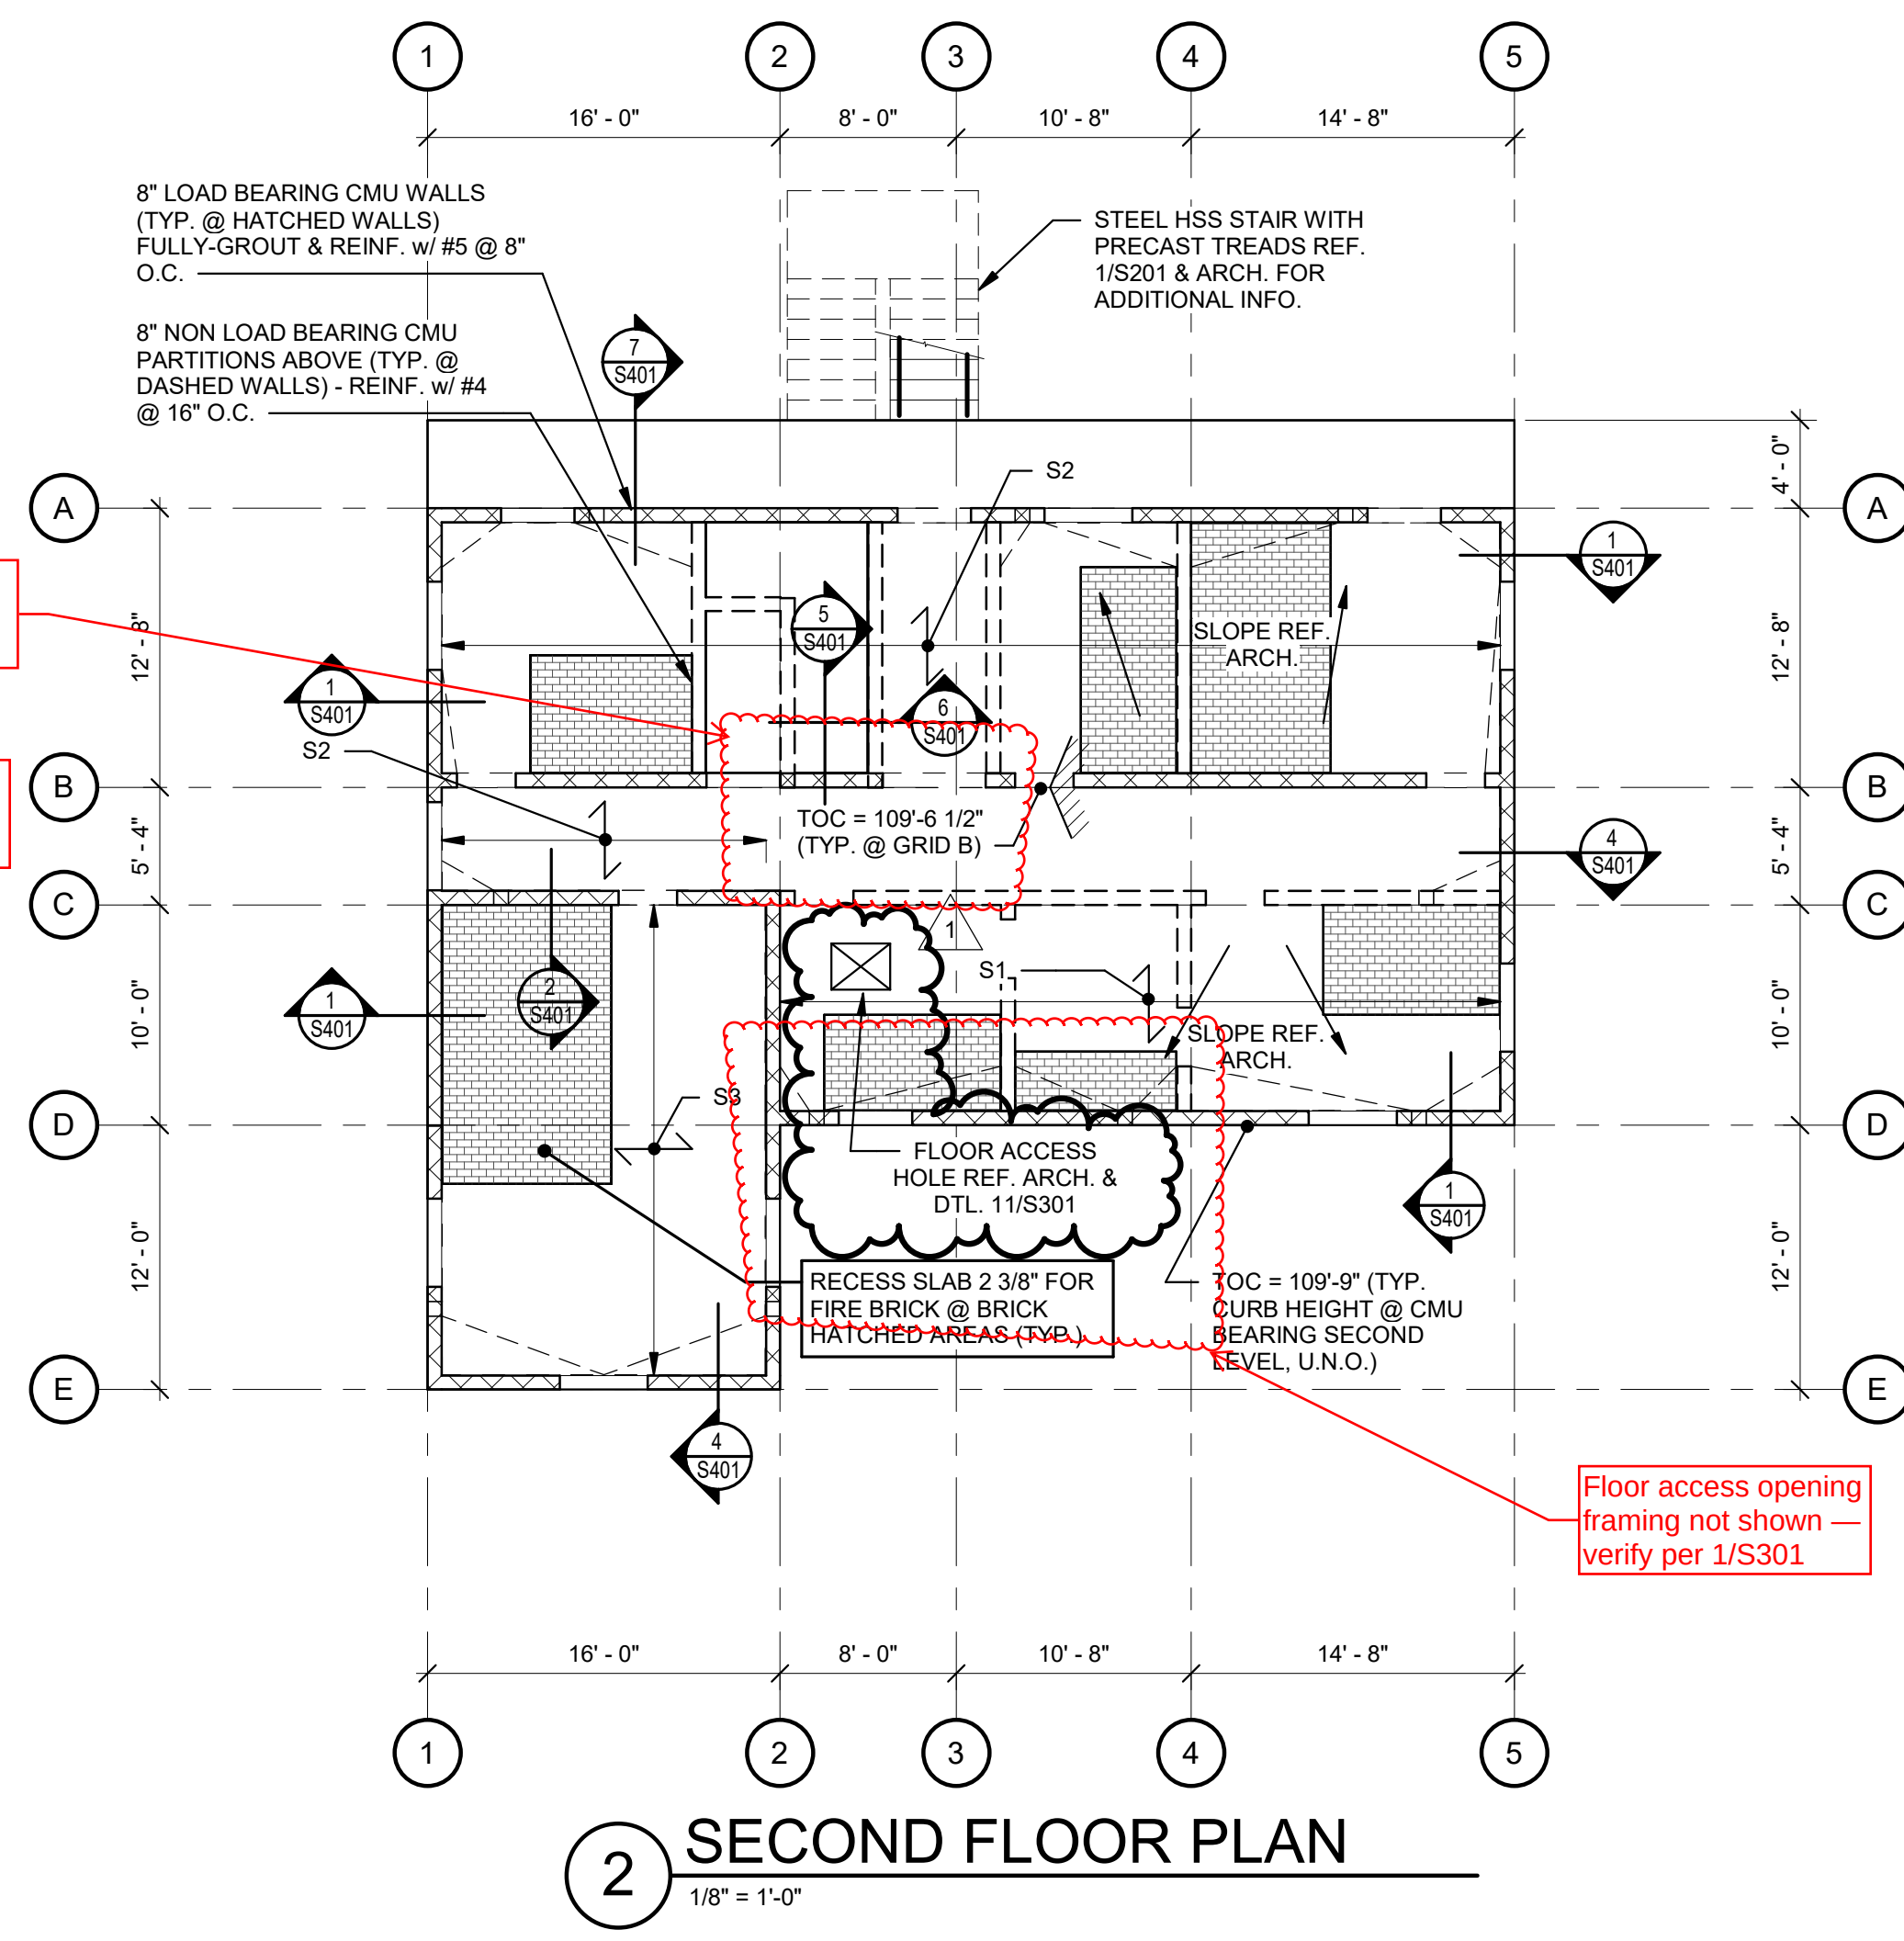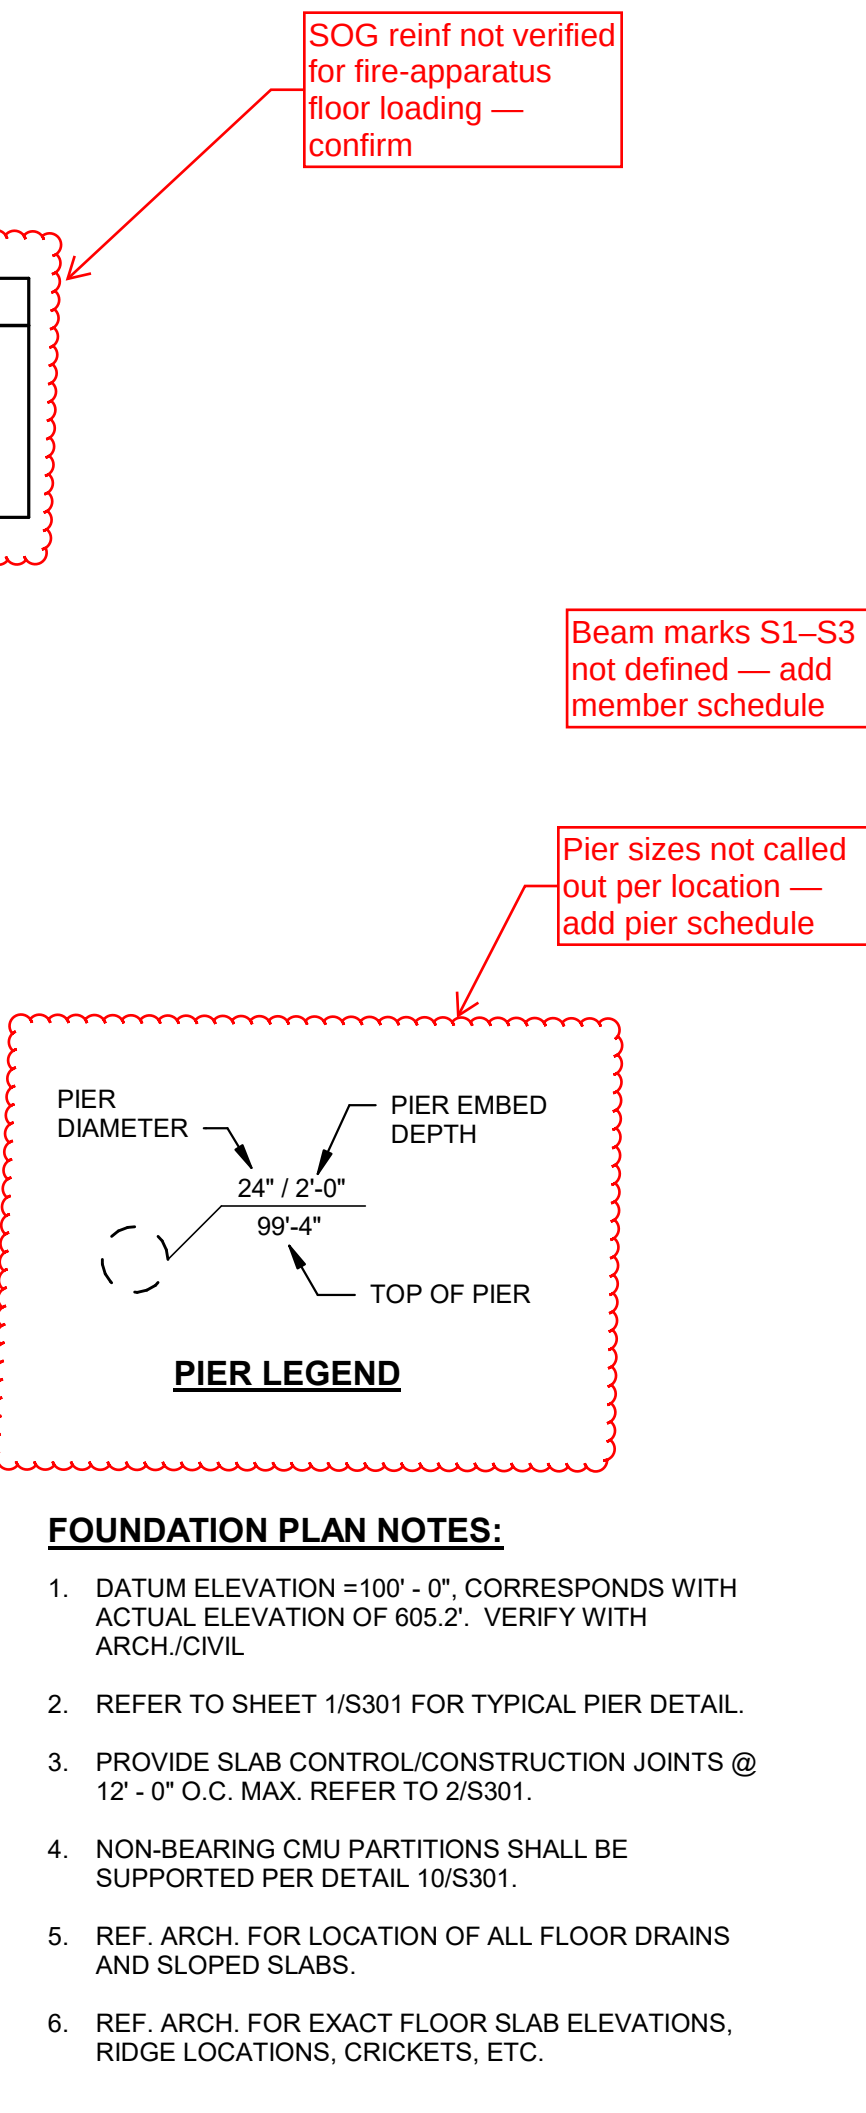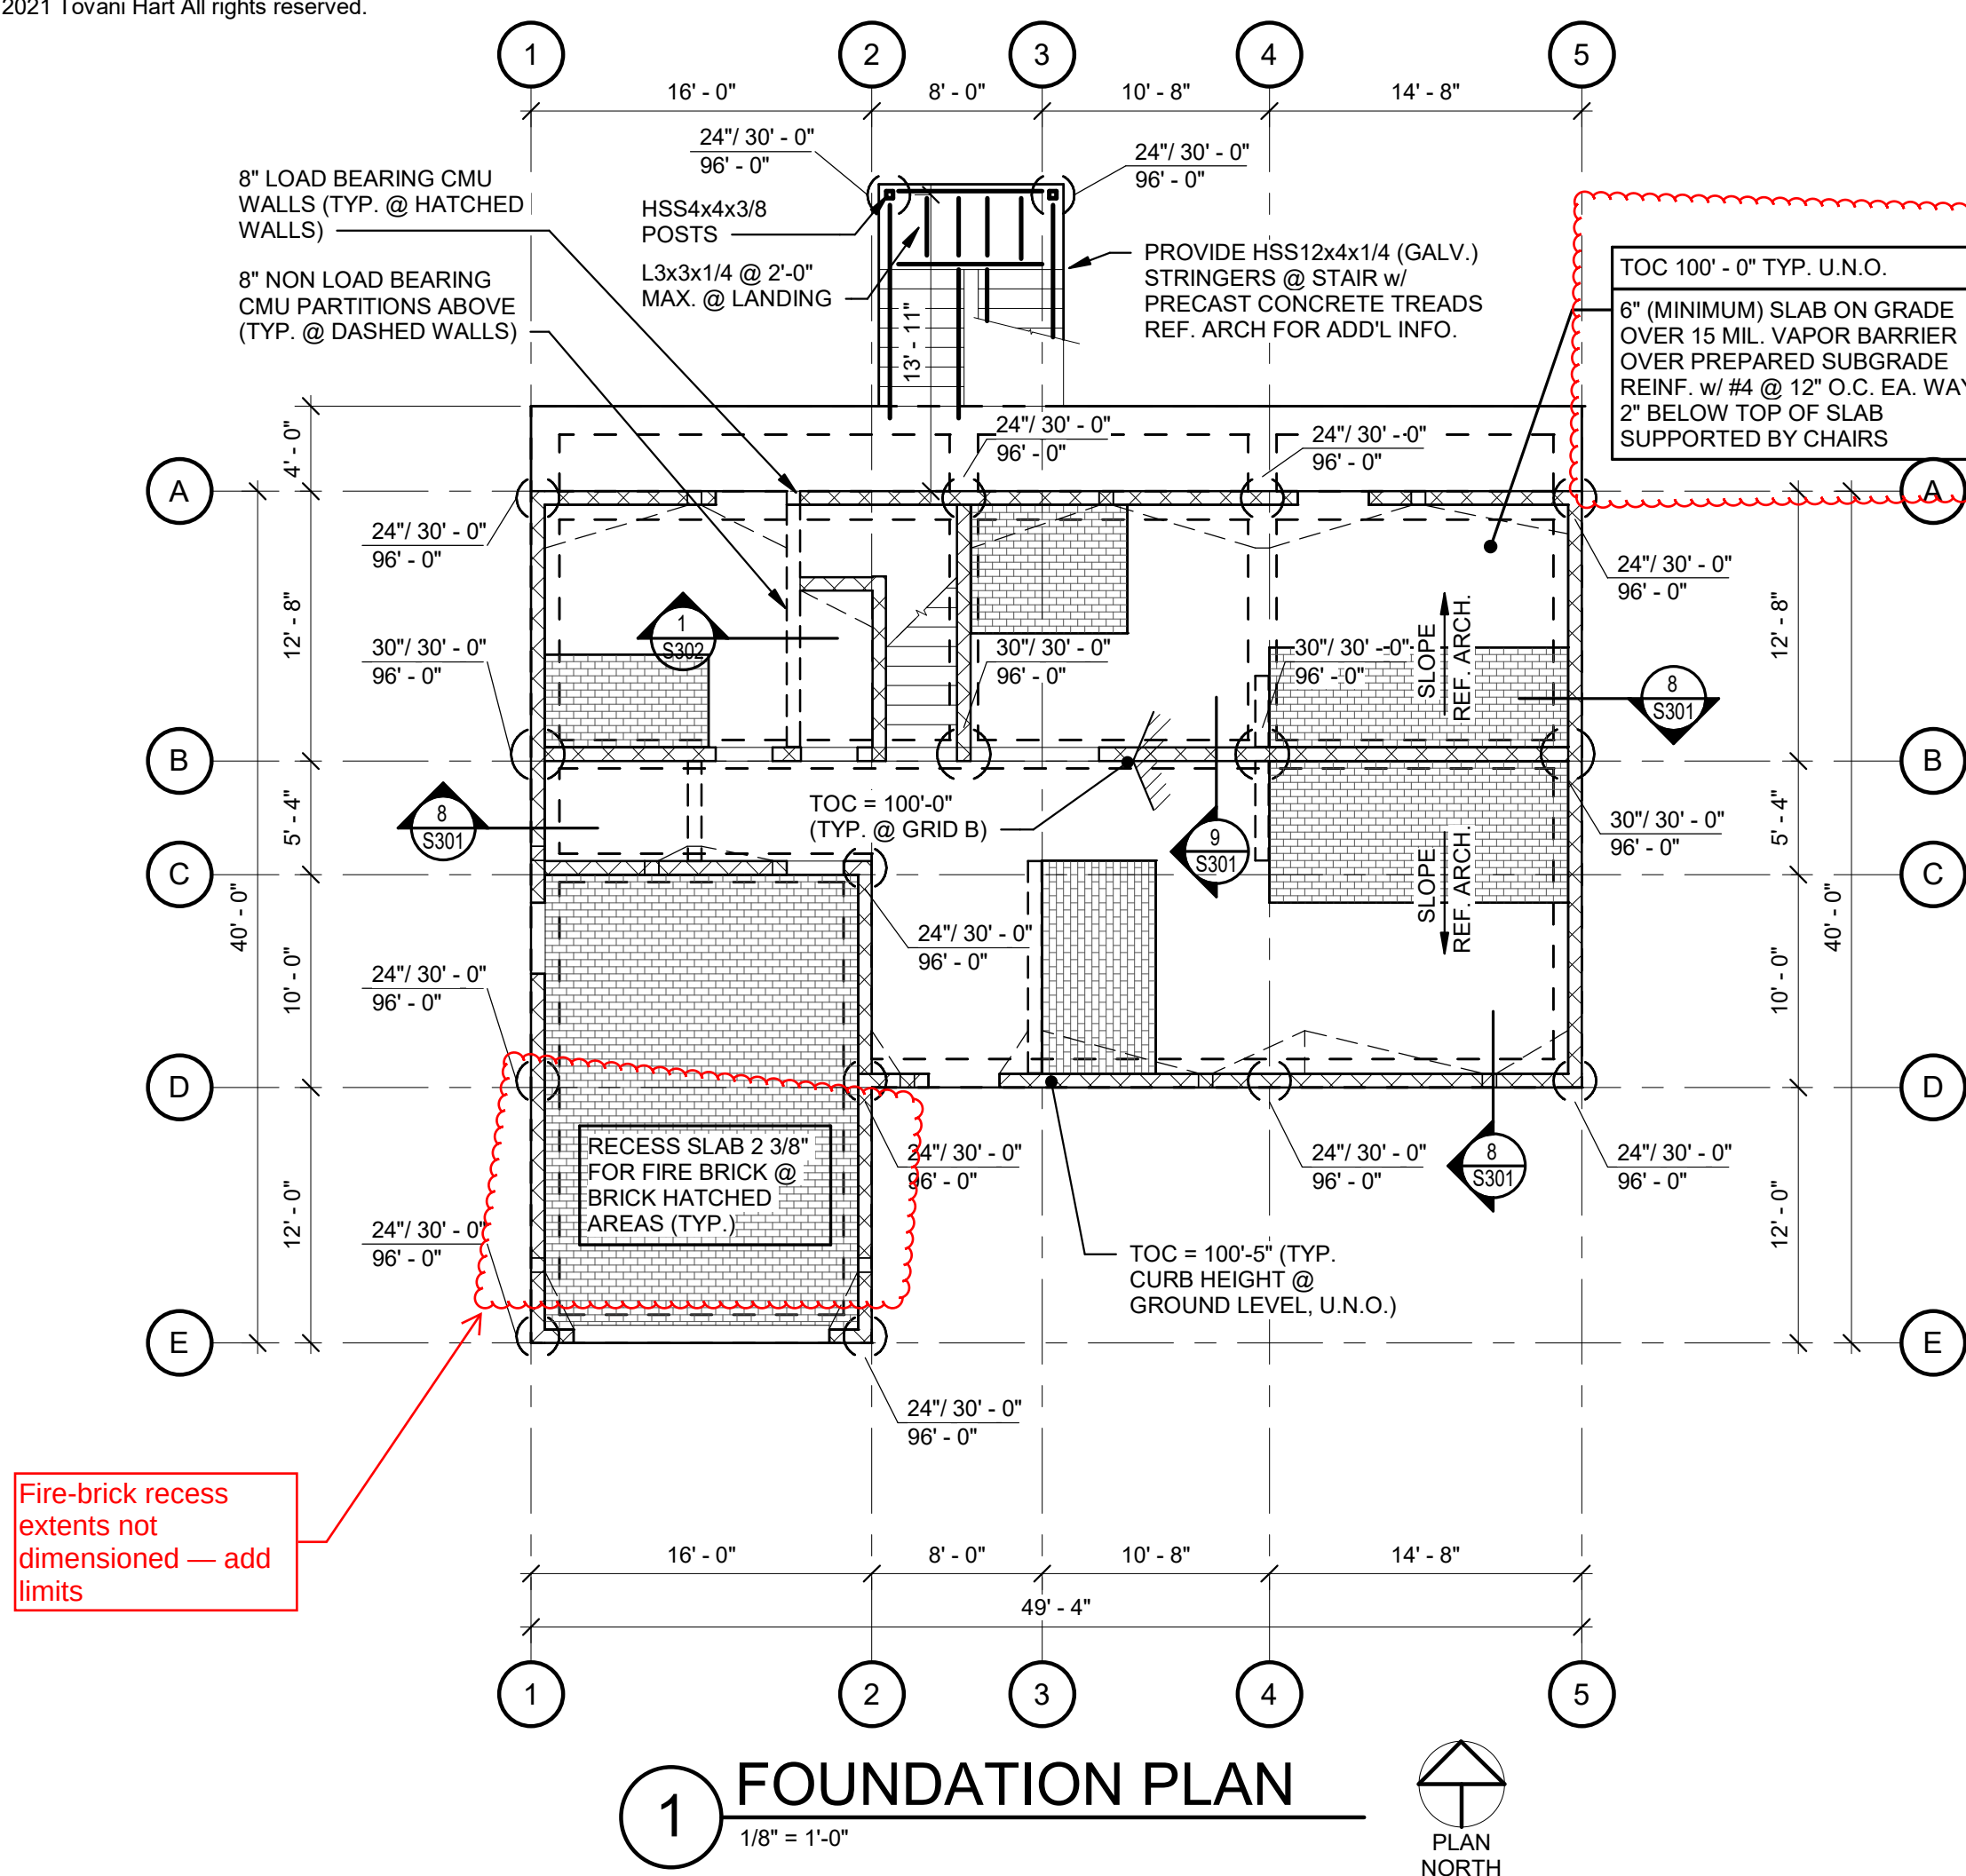

HART GAUGLER + ASSOCIATES
Structural + Civil Engineering Services
12801 N. Central Expressway, Suite 1400
Dallas, Texas 75243
972.239.5111 / 972.239.5055 fax
www.hartgaugler.com

DRAWN: DJ DESIGN: SWR HGA JOB #: 219330
TEXAS REGISTERED ENGINEERING FIRM #: F-5053