

ADD BLDG HT DIM.
(ALL ELEV'S) - PERMIT
REVIEW SET
REV 1

DR HDR 7'-0" - MIN
7'-4" IBC 1010.1.1

ADD PITCH CALLOUT
(~4:12)

SPEC PANEL MFR,
TYPE & COLOR


WAINSCOT - LABEL 4'-0" / GRAPHIC 3'-6" ?

place address numbers on building


??

OHD - ADD OPENING DIMS


4 South
1/16" = 1'-0"

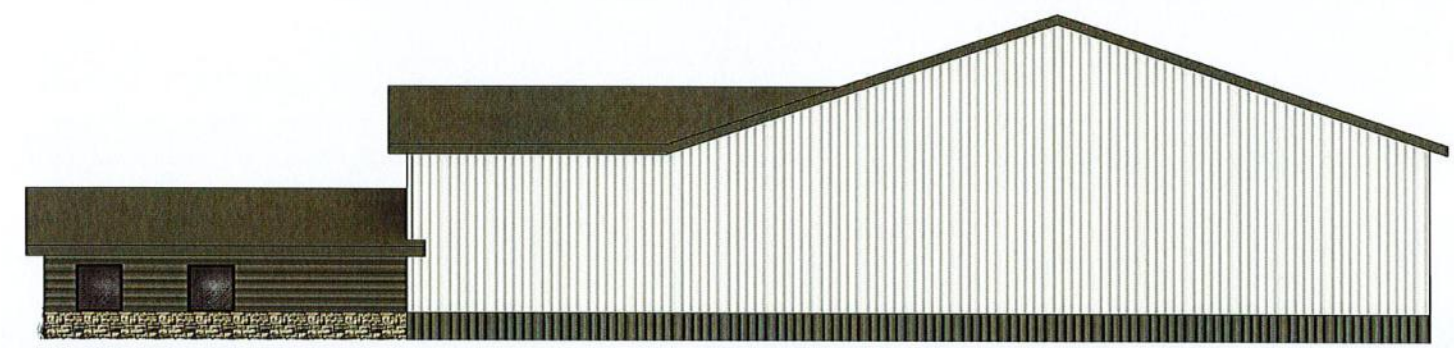

1 East
1" = 20'-0"

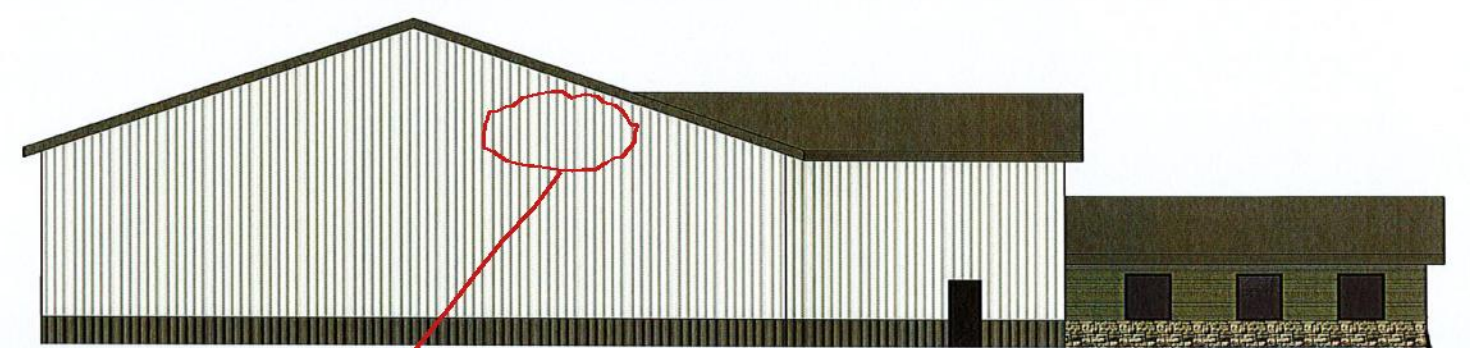

2 West
1/16" = 1'-0"
ADD SILL HT DIM. - EGRESS ANALYSIS verify?

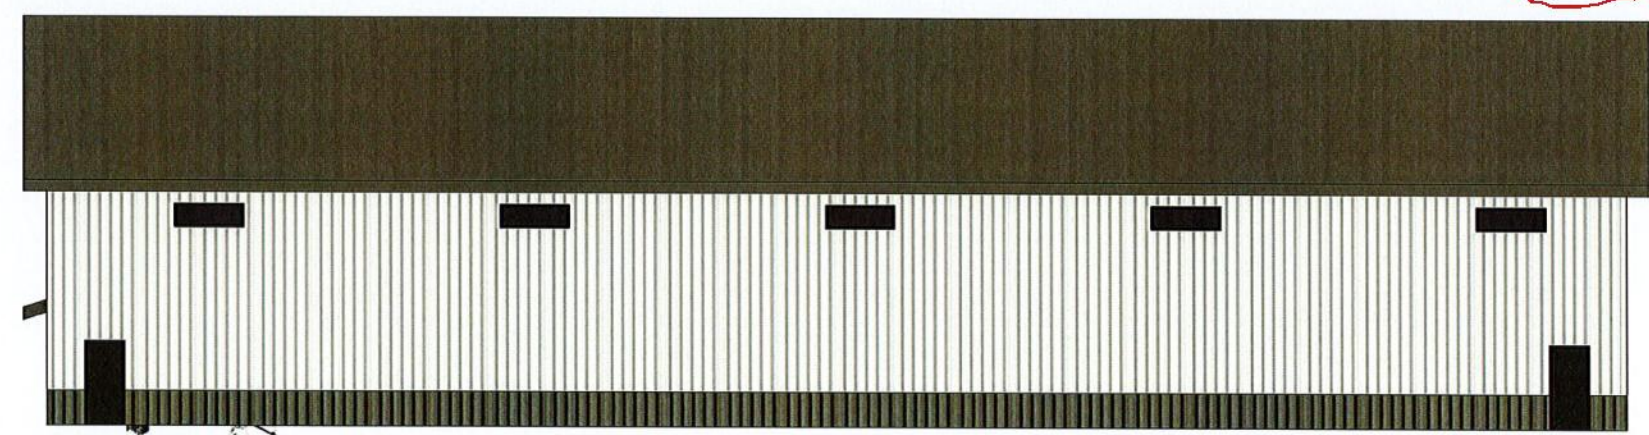

3 North
1/16" = 1'-0"



(605)-940-3802 JaversConstruction.com

HOH

Sq. Ft.	Area	Add.

Elevations		
Project number	N/A	105
Date	N/A	
Drawn by	ICB	
Checked by	CGJ	
		Scale As indicated

JK
5/17

FG LINE - VERIFY MATCHES C-401

11/12/2024 10:30:35 PM