


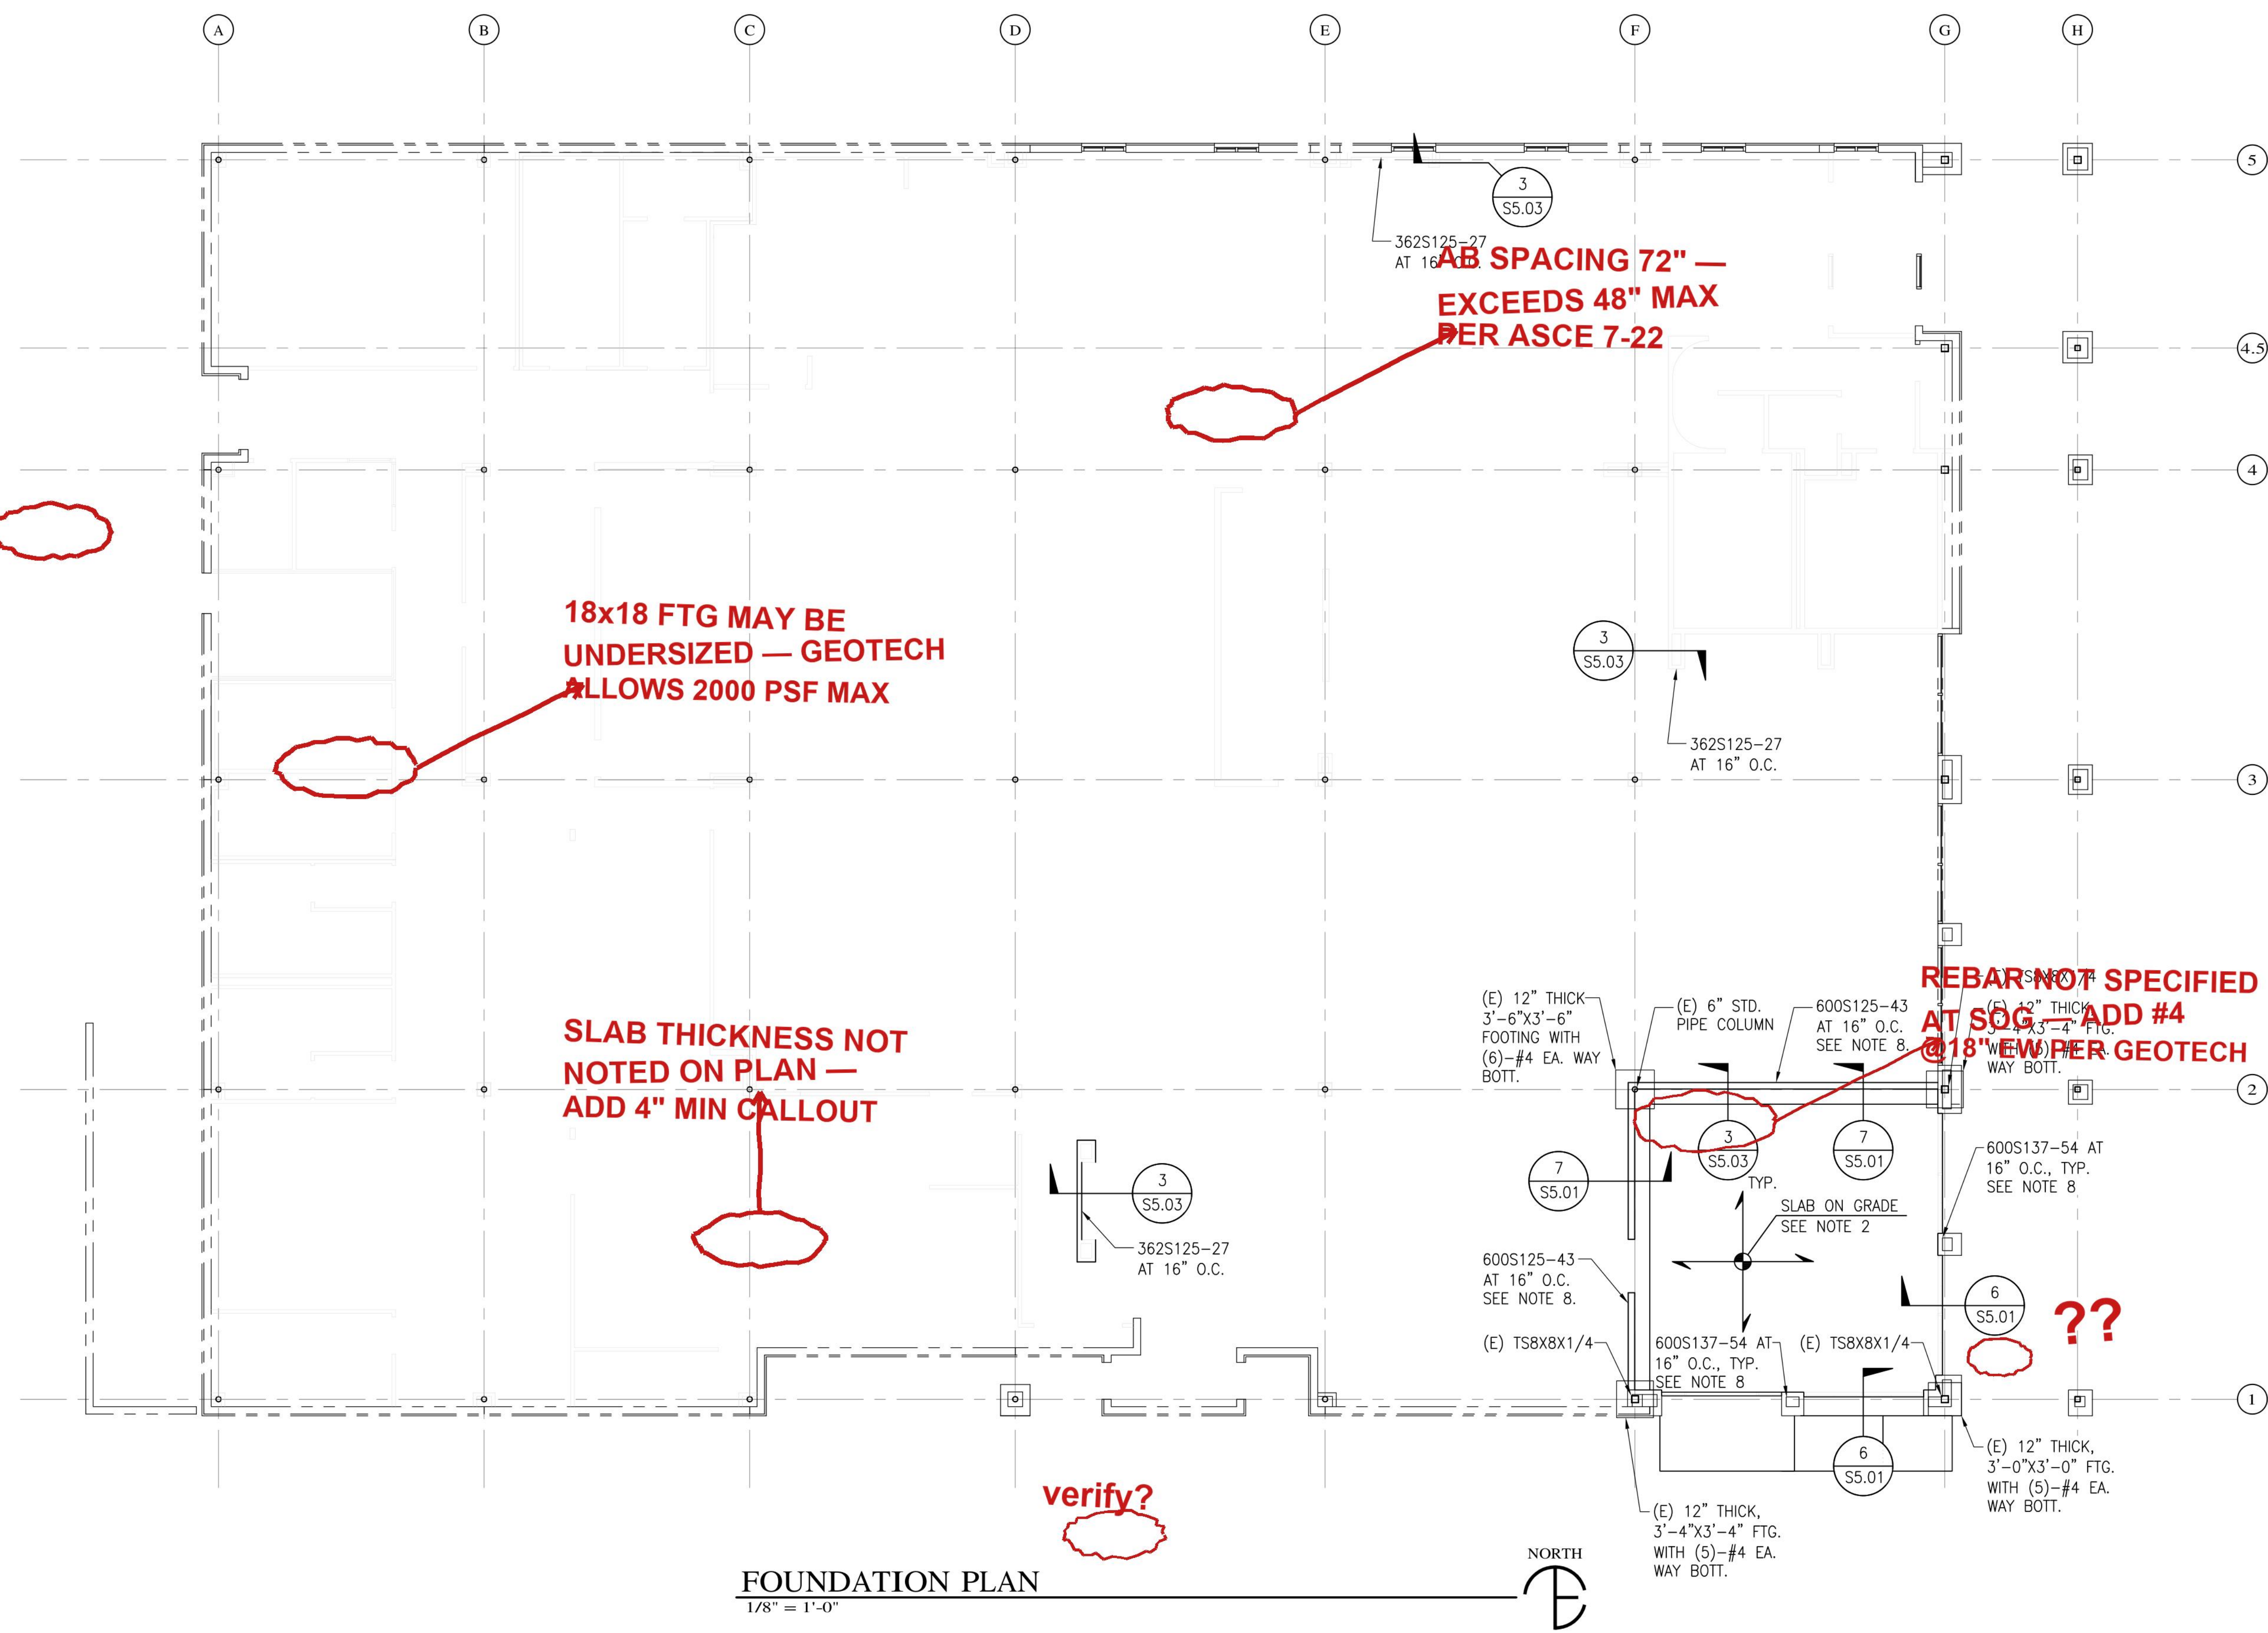

- FOUNDATION PLAN NOTES**
1. TOP OF SLAB ON GRADE ELEVATION 0'-0" U.N.O VERIFY WITH CIVIL AND/OR ARCHITECTURAL DRAWINGS.
 2. SLAB ON GRADE SHALL BE 5" THICK WITH #4 AT 24" EACH WAY 2" CLEAR FROM TOP OF SLAB. FOR METHOD OF PLACING SLAB ON GRADE, SEE 3/S5.01. FOR SLAB SLOPES, DEPRESSIONS, SLAB EDGE ETC. SEE ARCHITECTURAL DRAWINGS.
 3. FOR TYPICAL DETAILS, SEE SHEET S5.01. FOR GENERAL NOTES SEE SHEET S1.10.
 4. VERIFY ALL DIMENSIONS SHOWN WITH ARCHITECTURAL DRAWINGS.
 7. THESE DRAWINGS ARE BASED ON EXISTING AS BUILT STRUCTURAL DRAWINGS BY GB&L CONSULTING ENGINEERS DATED AUGUST 18, 1989.
 8. FOR COLD FORMED STEEL DETAILS, SEE SHEET S5.03

DWL
ARCHITECTS + PLANNERS, INC.
2333 N. Central Ave.
Phoenix, AZ 85004
tel 602.284.9731
dwalarchitects.com

THOMAS
Engineering LLC
Structural Engineering Consulting
4535 W. RUSSELL ROAD
SUITE 12
LAS VEGAS, NV 89118
TEL (702) 388-7755
FAX (702) 388-7766
www.thomasengr.com
JOB #: 1111

UNIVERSITY OF NEVADA, LAS VEGAS
**ARAMARK - STUDENT DINING
COMMONS ALTERATION**
4505 S. MARYLAND PARKWAY
LAS VEGAS, NV. 89119

ARAMARK
Innovative Dining Solutions
ARAMARK CORPORATION
ARAMARK INNOVATION CENTER
WANAMAKER BUILDING, 20th FLOOR
PHILADELPHIA, PA 19107

1	REVISIONS
06/06/11	PERMIT REVIEW
06/27/11	PERMIT REVIEW
07/08/11	PERMIT REVIEW

**CONSTRUCTION
DOCUMENTS**

KEY:

SHEET TITLE:
FOUNDATION PLAN

SHEET NUMBER:
S2.10

DRAWN BY: EK	REVIEWED BY: SN/M/T
DATE: 06/06/11	PROJECT NUMBER: 1101.00