

SITE PLAN CHECKLIST

1. LEGAL DESCRIPTION.
LOT 4, BLOCK 6, BAKKER LANDING 1ST ADDITION TO THE CITY OF TEA,
LINCOLN COUNTY, SOUTH DAKOTA.
2. ADDRESS(ES) KNOWN.
2030 MERCHANT STREET, TEA, SD 57064
3. NAME OF THE PROJECT/BUSINESS.
CRIBS WAREHOUSE
4. SCALE AND NORTH ARROW.
AS SHOWN ON PLANS.
5. PROPERTY LINES WITH DIMENSIONS AND PROPERTY AREA.
AS SHOWN ON PLANS. AREA = 1.92 ACRES OR 83,451.0 SF MORE OR
LESS.
6. ALL EXISTING AND PROPOSED BUILDINGS, ADDITIONS, AND CHANGES IN USE, SHOW
ALL DIMENSIONS AND GROSS FLOOR AREA FOR EACH USE (INCLUDE MEZZANINES).
AS SHOWN ON PLANS. SEE ARCHITECTURAL PLANS.
7. MANUFACTURING/WHOLESALE/WAREHOUSE - # EMPLOYEES ON MAXIMUM SHIFT:
N/A
8. BUILDING HEIGHT AND NUMBER OF STORIES.
SEE ARCHITECTURAL PLANS.
9. ALL PROTRUSIONS (BALCONIES, FIREPLACES, AIR CONDITIONERS, VESTIBULES,
OVERHANGS, ETC.).
AS SHOWN ON PLANS.
10. ALL EASEMENTS.
AS SHOWN ON PLANS.
11. FIRST FLOOR ELEVATIONS (SHOWN FLOODPLAIN AND OR FLOODWAY LINE IF
APPLICABLE).
AS SHOWN ON PLANS.
SITE SUBJECT PROPERTIES FLOOD ZONE PER FEMA FLOOD
INSURANCE RATE MAP COMMUNITY FLOOD INSURANCE RATE MAP (FIRM) 15083C0133C,
DATED APRIL 2, 2008. SITE IS LOCATED IN ZONE X.
MINIMAL FLOOD HAZARD. SEE SPECIFIC MAP FOR DETAILS
REGARDING LIMITS OF ZONES.
12. DISTANCE FROM ALL BUILDING LINES AND PARKING LOT BORDERS TO PROPERTY
LINES AT THE CLOSEST POINTS.
AS SHOWN ON PLANS.
13. PARKING LOT: DESIGNATE EACH SPACE (DIMENSIONS OF LOT, STALLS, AND AISLES).
THE PROPOSED PARKING LOT SURFACE, HANDICAP ACCESSIBLE AND COMPACT
SPACES (AND SHOW THE LOCATION OF SIGNAGE FOR BOTH), CURB/BUMPER BLOCKS,
AND STAKING SPACES (IF REQUIRED FOR DRIVE-UP WINDOW/DEVICE).
OF REGULAR STALLS - 13 STALLS
OF ACCESSIBLE STALLS - 1 STALL
OF TOTAL STALLS PROVIDED = 14
14. LOADING SPACE(S): SHOW LOCATION AND SIZE (14' X 35' IS REQUIRED).
N/A
15. PARKING LOT SCREENING: SHOW HEIGHT, LOCATION, AND TYPE OF MATERIAL TO
BE USED.
N/A
16. TRASH CONTAINER AREA(S) THAT ARE LOCATED OUTSIDE OF BUILDINGS AND
SCREENED HEIGHT AND MATERIAL.
AS SHOWN ON PLANS.
17. DESCRIBE THE USES OF ALL ADJACENT PROPERTY, INCLUDING ACROSS THE
STREET OR ALLEY.
NORTH: I-1 - LIGHT INDUSTRIAL
SOUTH: I-1 - LIGHT INDUSTRIAL
EAST: I-1 - LIGHT INDUSTRIAL
WEST: I-1 - LIGHT INDUSTRIAL
SUBJECT PROPERTY ZONE: I-1 - LIGHT INDUSTRIAL
18. CURB CUT(S) AND PUBLIC SIDEWALK (EXISTING AND PROPOSED).
AS SHOWN ON PLANS.
19. IF OUTSIDE LIGHTING IS PROPOSED, PROVIDE A PHOTOMETRIC PLAN TOGETHER
WITH A CATALOG CUT SHEET (PICTURE) SHOWING EACH TYPE OF FIXTURE, THE LUMENS
(OR WATTAGE) AND HEIGHT OF POLE MOUNTED FIXTURES ABOVE THE PARKING LOT
SURFACE. PHOTOMETRIC NOT REQUIRED IF NO LIGHTED CANOPY AND THE PROPERTY IS
NOT ADJACENT TO RESIDENTIALLY USED OR ZONED PROPERTY.
N/A
20. NAMES AND LOCATIONS OF ALL ADJACENT STREETS, ALLEYS, WATERWAYS, OR
OTHER PUBLIC WAYS.
AS SHOWN ON PLANS.
21. EITHER SUPPLY A SEPARATE LANDSCAPE PLAN OR DESCRIBE THE LOCATION, TYPE,
AND SIZE OF MATERIALS ON THE SITE PLAN. DESCRIBE THE GROUND COVER IN THE
REQUIRED FRONT YARD SETBACK.
LANDSCAPING AS SHOWN ON PLANS (TO RIGHT).
THE SITE WILL BE SEEDED, MULCHED, AND FERTILIZED
POST-CONSTRUCTION.
22. PROPOSED TOPOGRAPHY.
SEE GRADING PLAN ON SHEET C105.
23. ALL THE PUBLIC AND PRIVATE UTILITIES ON THE PROPERTY AND ADJACENT PUBLIC
PROPERTY.
AS SHOWN ON PLANS.
24. OWNER NAME AND ADDRESS.
CRIBS, LLC
PO BOX 459
TEA, SD 57064
25. DEVELOPER NAME, ADDRESS, AND PHONE NUMBER.
JAVERS CONSTRUCTION
PO BOX 459,
TEA, SD 57064
PROJECT MANAGER: CHAD JAVERS
EMAIL ADDRESS: chad@javersconstruction.com
PHONE NUMBER: 605-940-1800

TREE SPECIES CONFLICTS
W/ POWER LINE CLEAR. —
USE LOW-GROWTH TYPE


TREE 8' FROM UTIL.
EASEMENT — VERIFY
MIN. SETBACK REQ'D

IRRIGATION COVERAGE
MISSING AT E CORNER —
ADD ZONE OR HEADS

SHRUB SPACING 8' O.C.
NON-STANDARD — LOCAL
CODE REQ'S 5' MAX

GROUND COVER TYPE
NOT SPECIFIED AT
BORENTENTION AREA

??

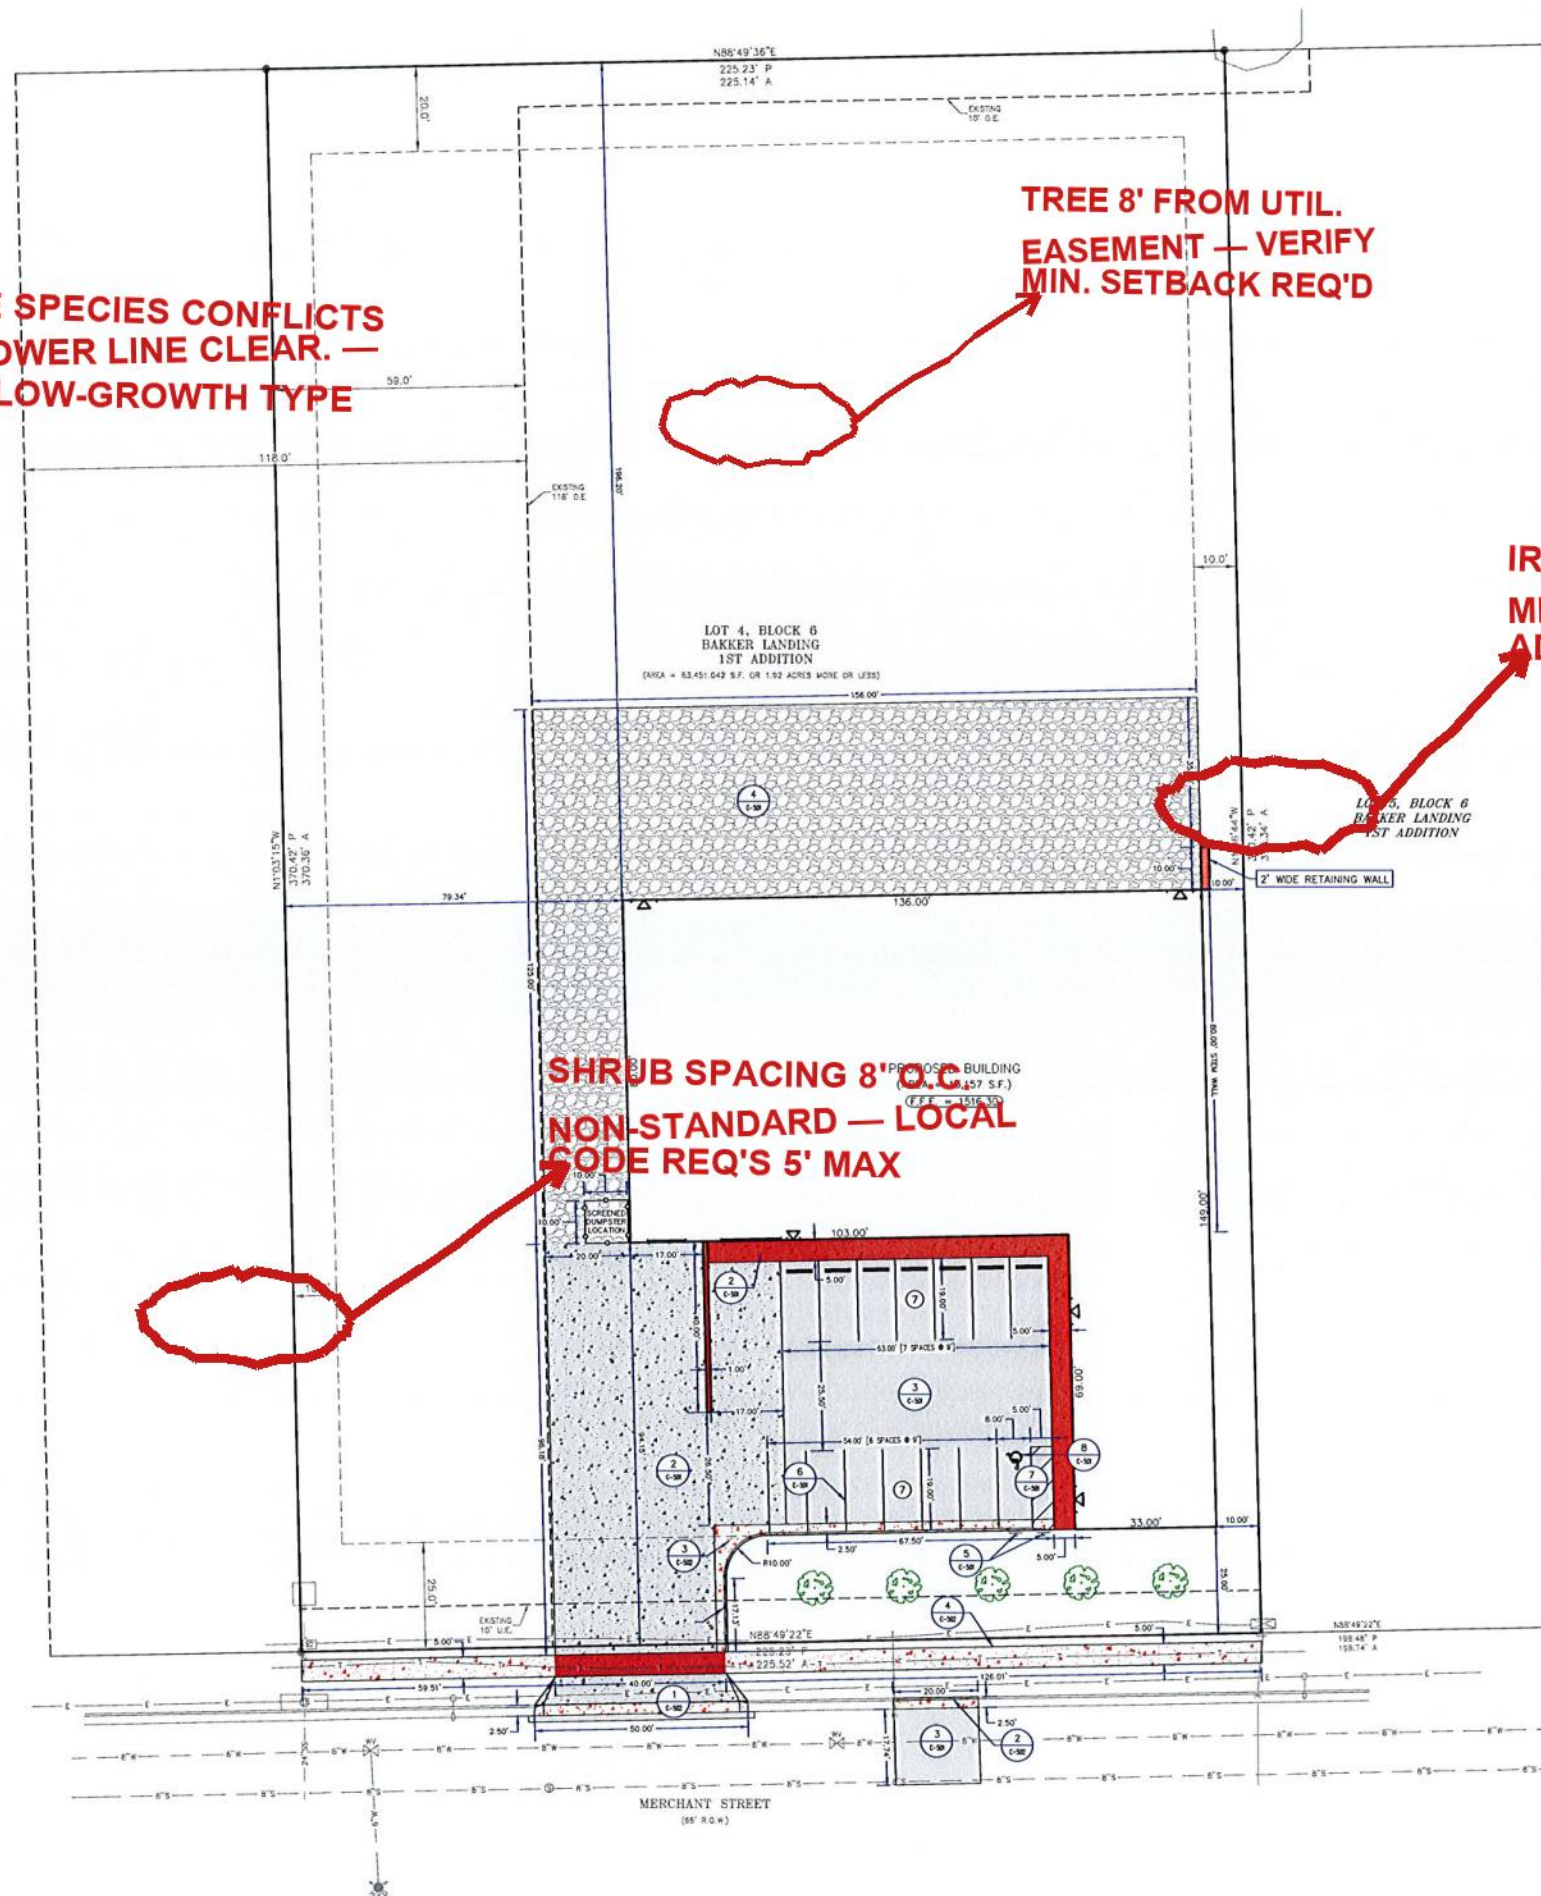

LEGEND

- EXISTING LOT LINE
- PROPOSED LOT LINE
- SETBACK
- EXISTING EASEMENT
- PROPOSED P.C.C. VALLEY GUTTER AND CURB & GUTTER
- PROPOSED 4" P.C.C. SIDEWALK
- PROPOSED 6" P.C.C. SIDEWALK
- PROPOSED LIGHT DUTY ASPHALT SECTION
- PROPOSED LIGHT DUTY CONCRETE SECTION
- PROPOSED ASPHALT SECTION
- PROPOSED CONCRETE SECTION
- TIP GUTTER OUT
- DROPPED CURB (1/4")

GENERAL NOTES

1. IMPORTANT: THE CIVIL AND ARCHITECTURAL SITE PLANS REFLECT THE DESIGN INTENT FOR THE SITE AND SHOULD NOT HAVE ANY MATERIAL DISCREPANCIES. REPORT ANY DISCREPANCIES TO THE ARCHITECT AND THE CIVIL ENGINEER IMMEDIATELY. THE CIVIL SITE PLAN SHEET WILL CONTAIN THE DIMENSIONING, SLOPING & GRADING, SPOT ELEVATIONS, & OTHER REQUIREMENTS.
2. CONTRACTOR TO VERIFY ALL EXISTING SITE CONDITIONS PRIOR TO SITE PREPARATION. REPORT ANY DISCREPANCIES TO ARCHITECT AND CIVIL ENGINEER IMMEDIATELY.
3. CONTRACTOR TO VERIFY ANY CRITICAL DIMENSIONS WITH REGARDS TO EXISTING CONSTRUCTION, IF ANY.
4. ALL DIMENSIONS ARE TO THE BACK OF CURB (WHERE APPLICABLE) UNLESS NOTED OTHERWISE.
5. PROVIDE A 1/2-IN EXPANSION JOINT BETWEEN ALL CONCRETE PAVEMENTS AND THE BUILDING AND ALL OTHER STRUCTURES OR INTRUSIONS. REFER TO DETAIL 1/C501 FOR CONCRETE PAVEMENT JOINTING PLANS.
6. THE DEVELOPMENT PLANS HAVE BEEN REVIEWED WITH THE PREPARATION OF THIS SITE PLAN.

STREET TREES

MERCHANT STREET FRONTAGE:
1 TREE / 50' FRONTAGE = 226' / 50' = 5 TREES
TOTAL TREES REQUIRED = 5 (PROVIDED = 5)
STREET TREES SHALL BE A MINIMUM OF 2 IN CALIPER AND SPACING SHALL BE A MINIMUM OF 14 IN CALIPER. TREES SHALL BE A MIX OF APPROVED SPECIES. CONTACT THE CITY OF SIOUX FALLS FORESTRY OFFICE FOR A LIST OF APPROVED VARIETIES (605-367-8150).
MINIMUM NUMBER OF TREE SPECIES = 2
FINAL TREE LOCATION TO BE DETERMINED UPON CONSTRUCTION.
SPECIES:
1. SUGAR MAPLE
2. BLACK MAPLE

PROJECT NO. SD231009	
REVISIONS	BY DATE DESCRIPTION
NO.	1 1/3/25 PER CITY REVIEW
EHRHART GRIFFIN & ASSOCIATES 601 N. Minnesota Ave. Sioux Falls, So. Dak. 57104 P: 605 / 339-7215 F: 605 / 339-7271 • ENGINEERING • PLANNING • LAND SURVEYING	
HOH WAREHOUSE SITE & LANDSCAPING PLAN LOT 4, BLOCK 6, BAKKER LANDING 1ST ADDITION TEA, SD 57064	
DATE: 01/13/25 DESIGNED BY: MAS DRAWN BY: MAS CHECKED BY: DFG CREW: LRM	
PROGRESS SET NOT FOR CONSTRUCTION	
SHEET NO. C-104	