

H V A C L E G E N D

- TYPE "C" GRILLE (SEE SCHEDULE)
6"Ø ROUND NECK
60 CFM
- EXISTING DUCTWORK, PIPING OR
EQUIPMENT TO REMAIN
- NEW DUCTWORK, PIPING OR EQUIPMENT
BY CONTRACTOR

OUTLINE SPECIFICATIONS

1. ALL WORK SHALL COMPLY WITH THE 2009 EDITION OF THE INTERNATIONAL ENERGY CONSERVATION CODE, THE 2018 EDITIONS OF THE INTERNATIONAL BUILDING CODE, INTERNATIONAL MECHANICAL CODE, INTERNATIONAL PLUMBING CODE, INTERNATIONAL FUEL GAS CODE AND OTHER REQUIREMENTS OF NFPA, EPA AND ALL OTHER AUTHORITIES HAVING JURISDICTION OVER THIS WORK.
2. THE CONTRACTOR SHALL PAY ALL FEES AND SECURE ALL LICENSES AND PERMITS REQUIRED FOR THE WORK INDICATED ON THE MECHANICAL DRAWINGS.
3. ALL DUCTWORK SHALL MEET SMACNA STANDARDS AND CONSTRUCTED AND ERECTED IN ACCORDANCE WITH THE INTERNATIONAL MECHANICAL CODE FOR LOW PRESSURE DUCT SYSTEMS. ALL LONGITUDINAL AND TRANSVERSE JOINTS, SEAMS AND CONNECTIONS SHALL BE SECURELY FASTENED AND SEALED WITH GASKETS, MASTICS OR MASTIC-PLUS-EMBEDDED-FABRIC TAPE INSTALLED IN ACCORDANCE WITH THE MANUFACTURER'S INSTRUCTIONS.
4. AS-BUILT PRINTS SHALL BE PROVIDED TO THE OWNER AT PROJECT CLOSEOUT.
5. CONTRACTOR SHALL PROVIDE 1 YEAR GUARANTEE ON ALL EQUIPMENT AND WORK.

HVAC NOTES:

DEMOLITION PLANS ARE BASED ON "AS-BUILT" PRINTS; SOME FIELD DISCREPANCIES MAY EXIST.




REFER TO ARCHITECTURAL DRAWINGS FOR ACTUAL BUILDING CONFIGURATION, DIMENSIONS, ETC.

WHERE AN EXISTING CEILING GRILLE IS IN GOOD REPAIR, CLEAN GRILLE AND RE-USE.

WHERE AN EXISTING CEILING GRILLE IS IN POOR REPAIR, REPLACE GRILLE WITH TYPE AND SIZE SHOWN ON HVAC RENOVATION PLANS. RE-USE EXISTING RUNOUT OR DUCTWORK IF POSSIBLE. IF EXISTING RUNOUT OR DUCTWORK CAN NOT BE RE-USED, REPLACE WITH NEW DUCTWORK OF SAME TYPE AS EXISTING.

THE CONTRACTOR IS RESPONSIBLE FOR THE DISPOSAL OF ALL UNUSED GRILLES, DUCTWORK, ETC. AFTER FIRST ALLOWING THE OWNER THE OPPORTUNITY TO KEEP ANY ITEMS THEY CHOOSE.

EXAMINE EXISTING DUCTWORK AND INSULATION WITHIN PROJECT FOOTPRINT. REPORT TO THE OWNER ANY AREAS WHERE DAMAGE EXISTS.

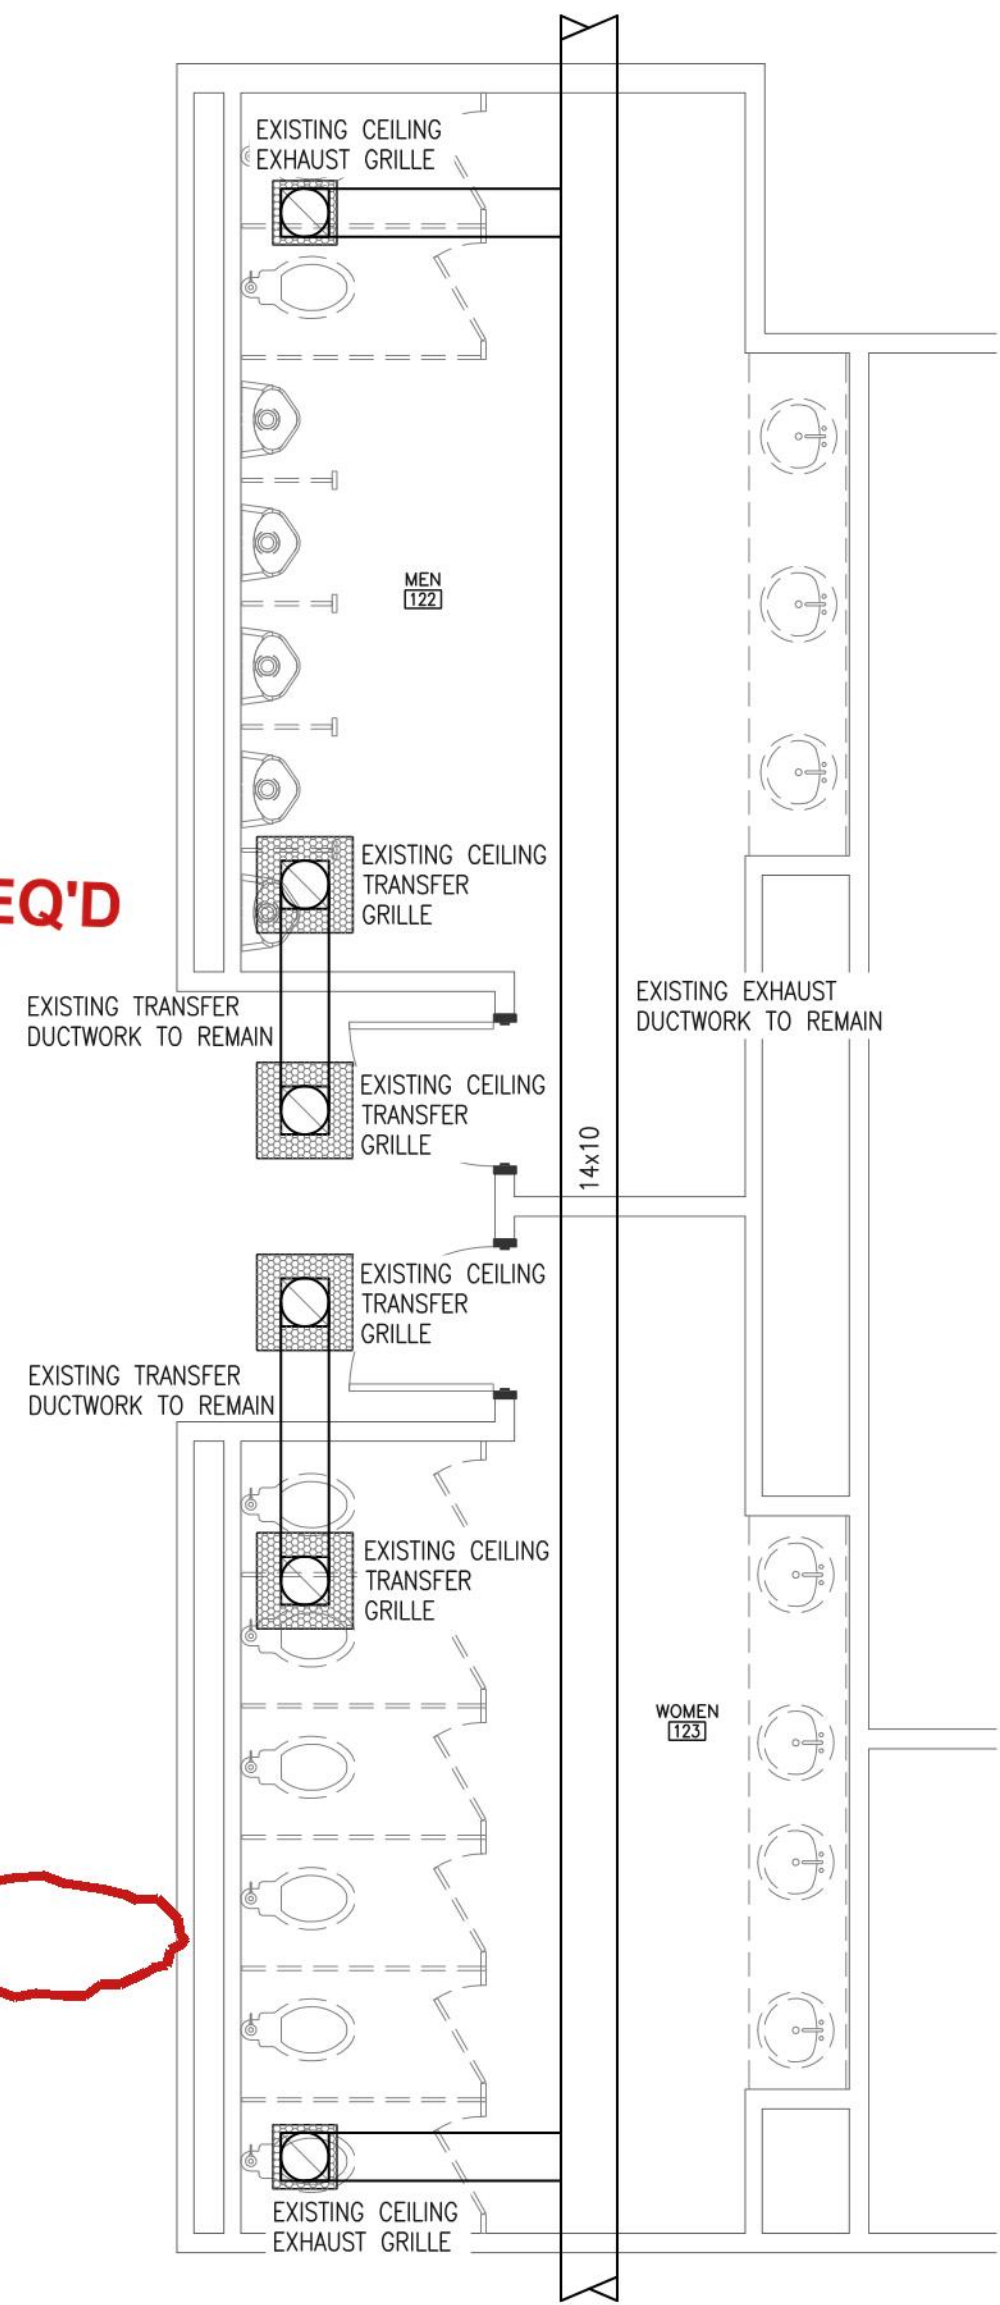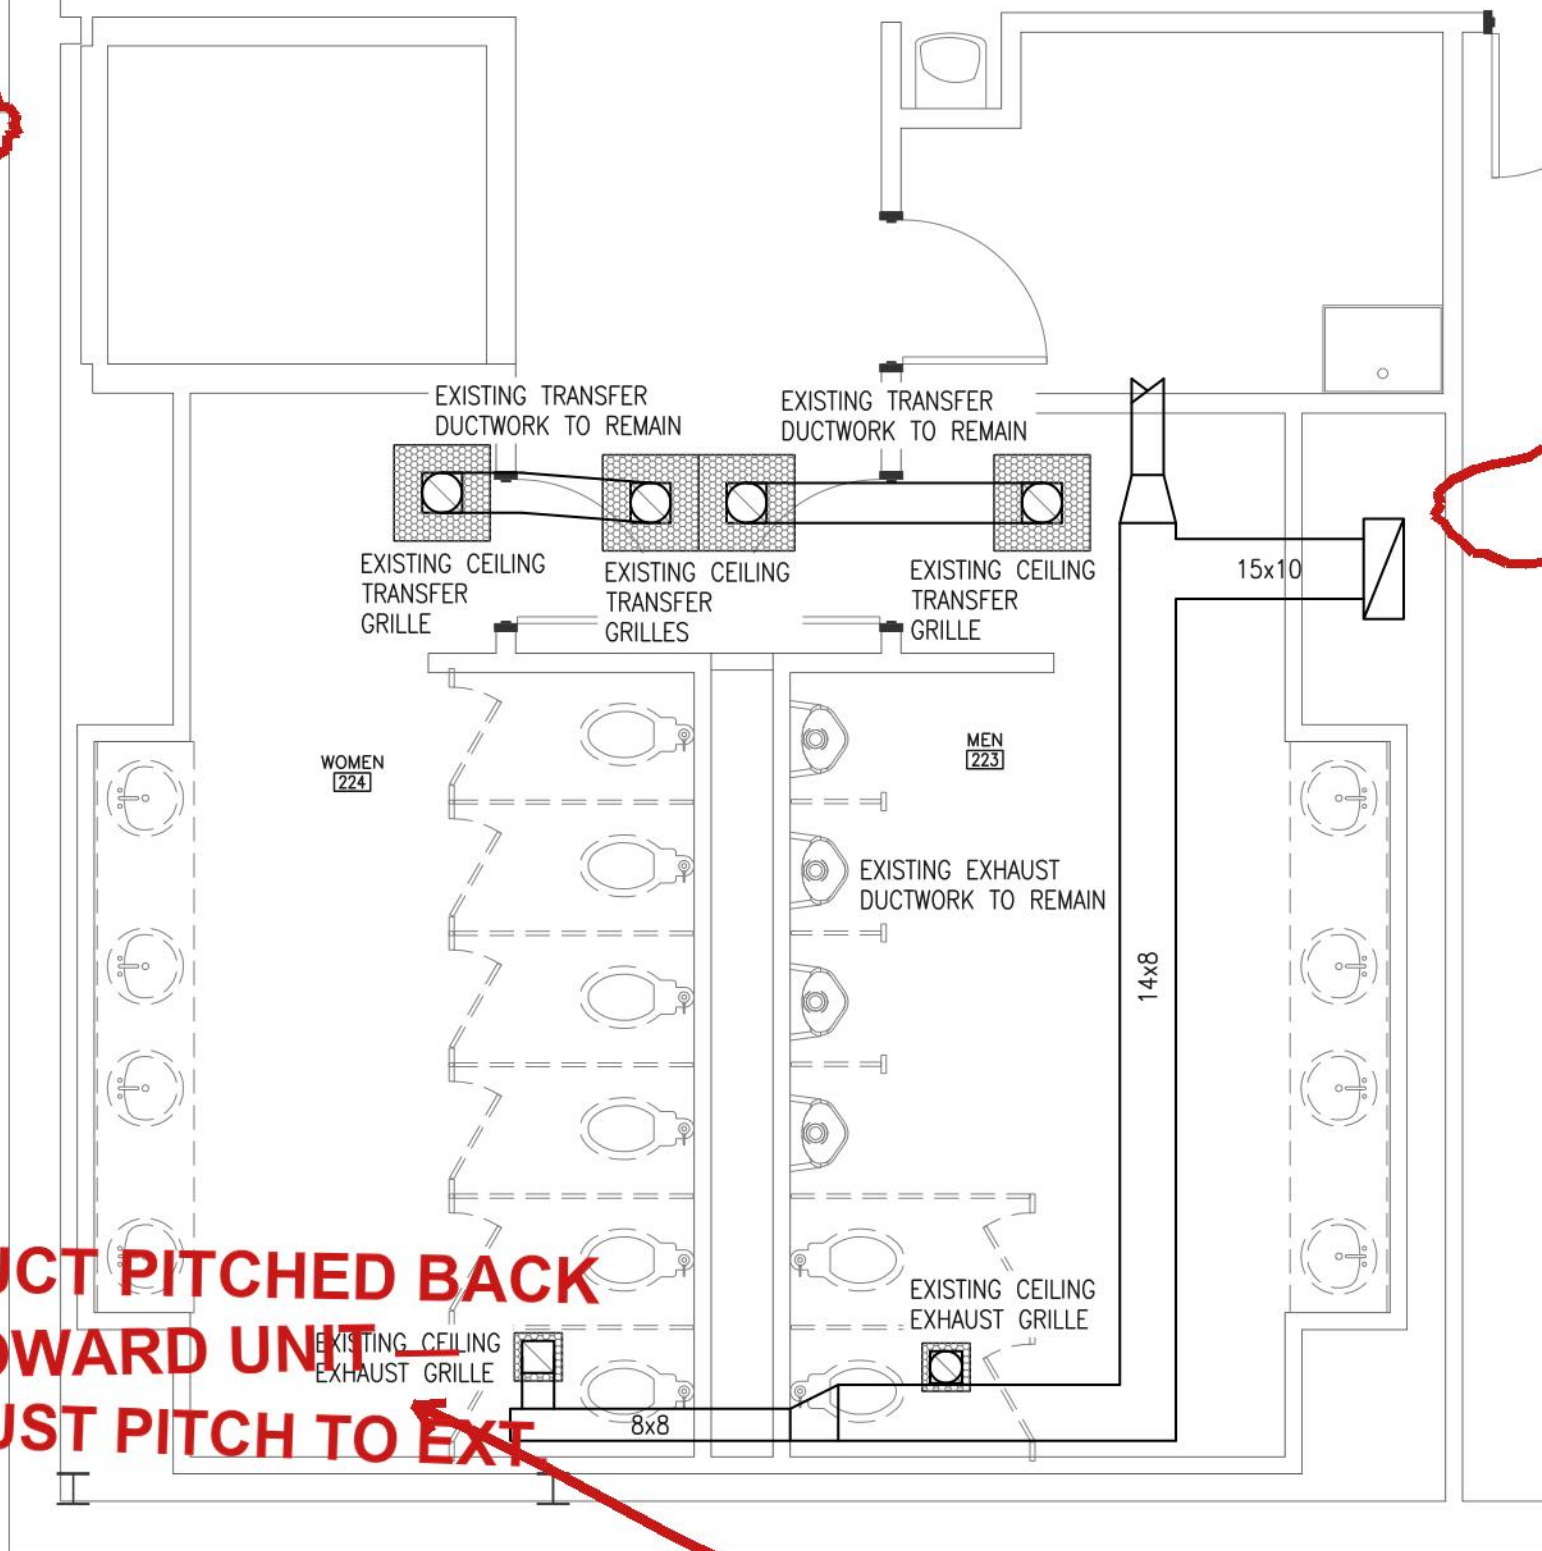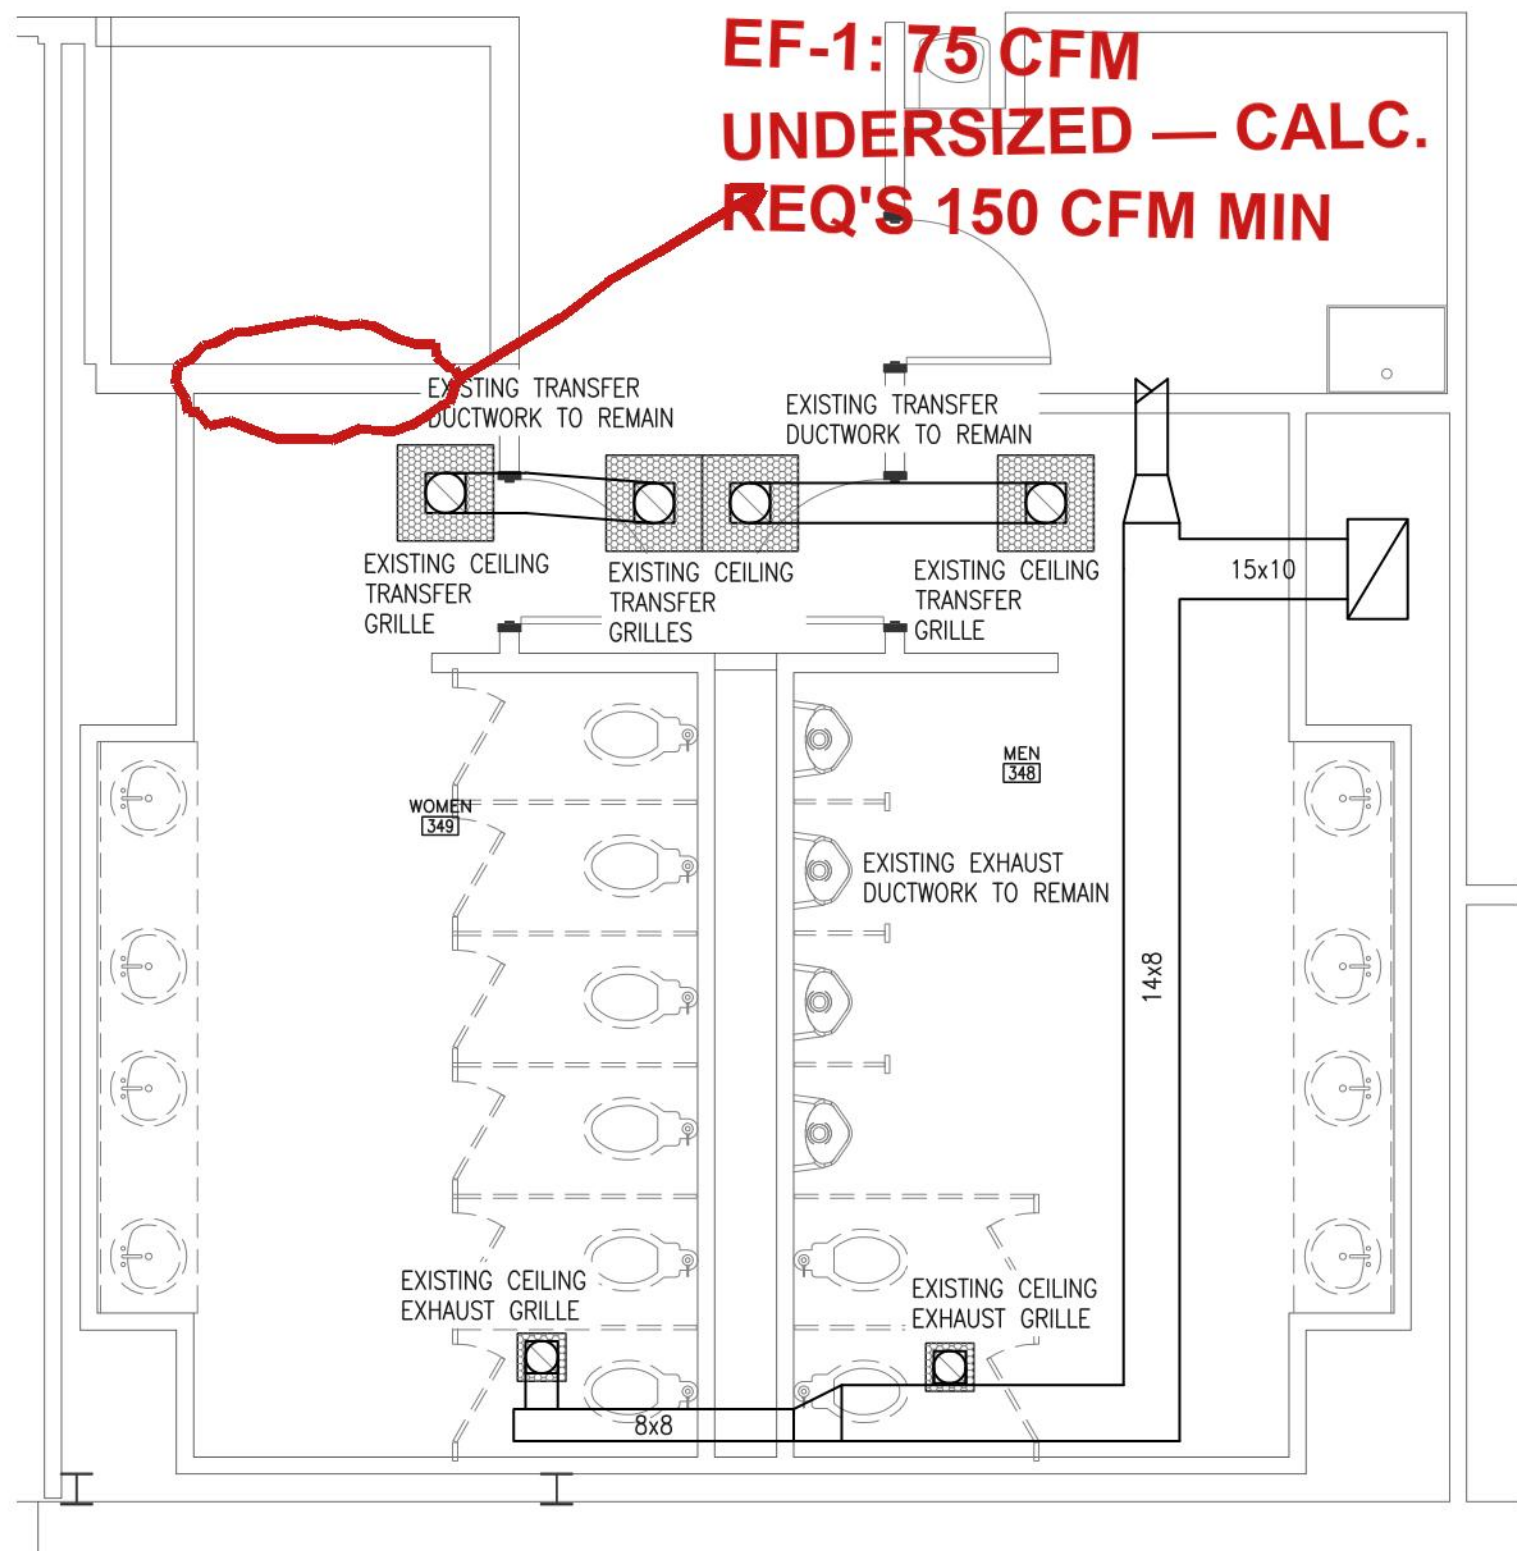

3 THIRD FLOOR GROUP TOILET ENLARGED HVAC DEMOLITION FLOOR PLAN
1/4" = 1'-0"




2 SECOND FLOOR GROUP TOILET ENLARGED HVAC DEMOLITION FLOOR PLAN
1/4" = 1'-0"

1 FIRST FLOOR GROUP TOILET ENLARGED HVAC DEMOLITION FLOOR PLAN
1/4" = 1'-0"

ADD ACCESS PANEL
FOR EF-2 ABOVE
CEILING — MIN 24x24

AIR DISTRIBUTION SCHEDULE											
SYMBOL	MOUNTING	PRICE MODEL NO.	METAL-AIRE MODEL NO.	TITUS MODEL NO.	FRAME SIZE (IN)	FACE TYPE	NECK	FINISH (FACE/INT)	USE	MATERIAL	REMARKS
B	LAY-IN	APDDR	7000R-6	PAR-AA	24X24	PERFORATED	ROUND	WHT/WHT	RET/EXH	ALUMINUM	--
D	SURFACE/CEILING	APDDR	7000R-1	PAR-AA	NECK + 2	PERFORATED	ROUND	WHT/WHT	RET/EXH	ALUMINUM	1

1. FURNISH WITH PLASTER FRAME.

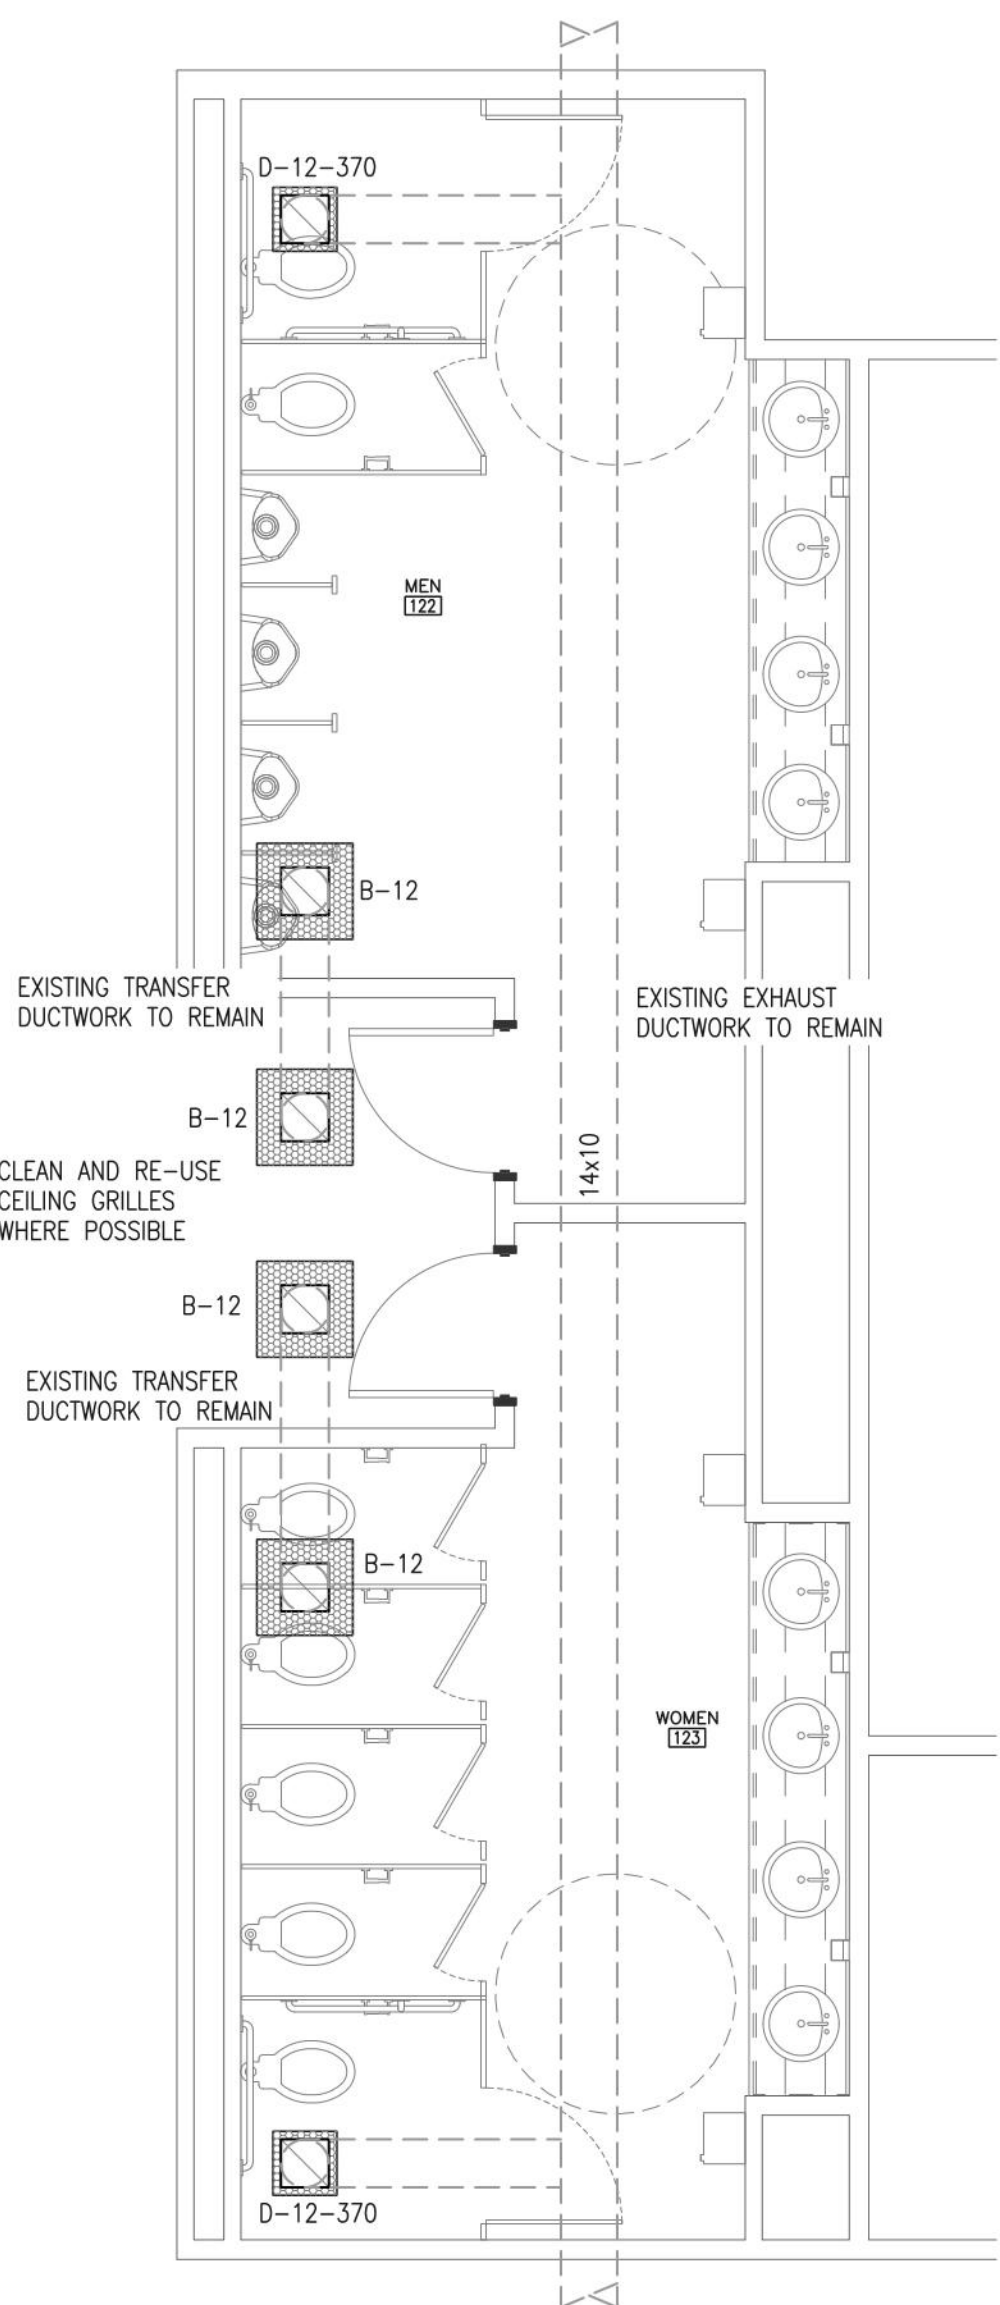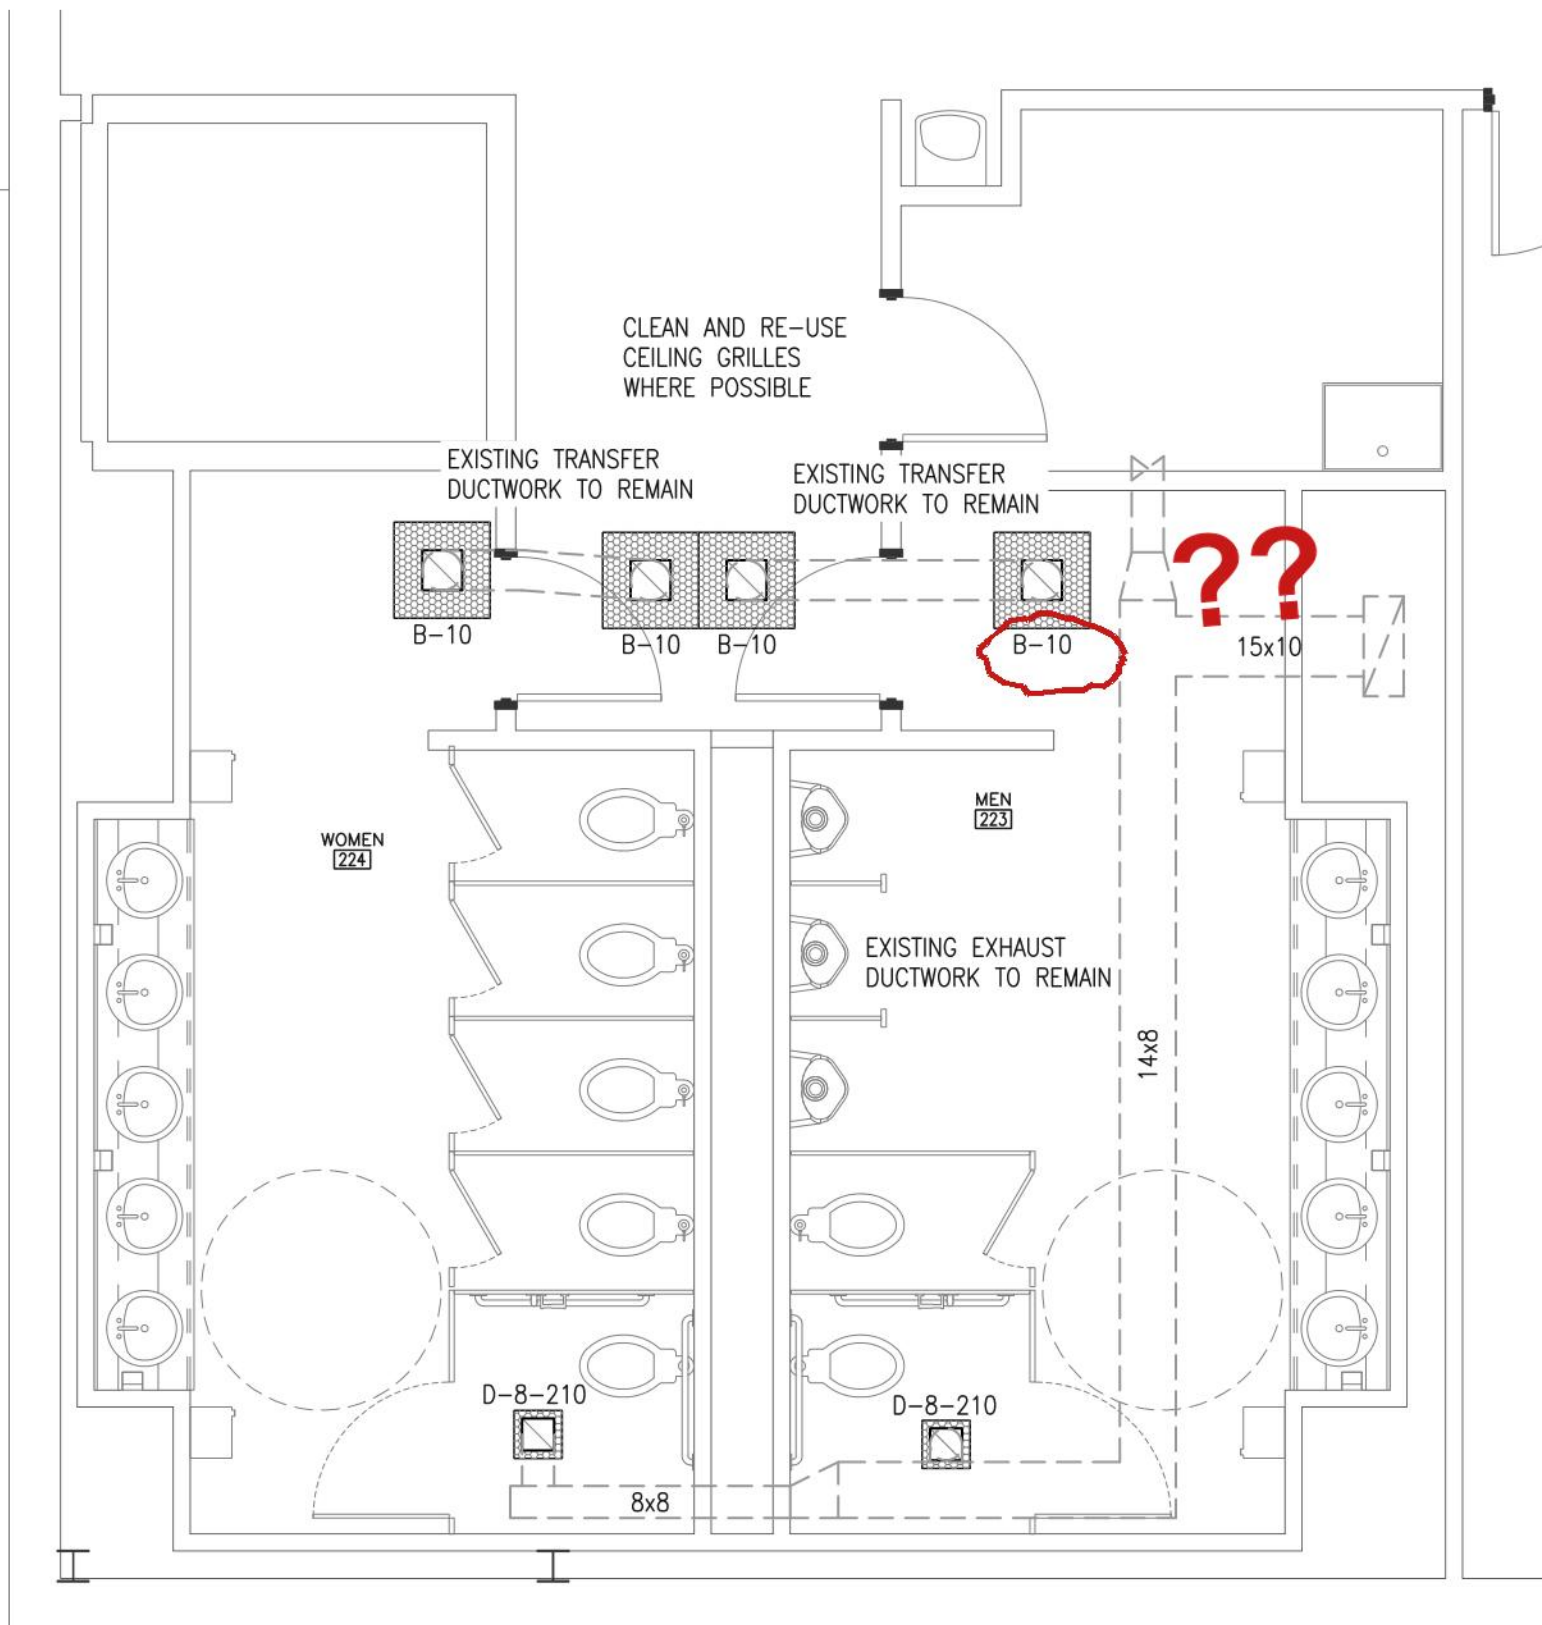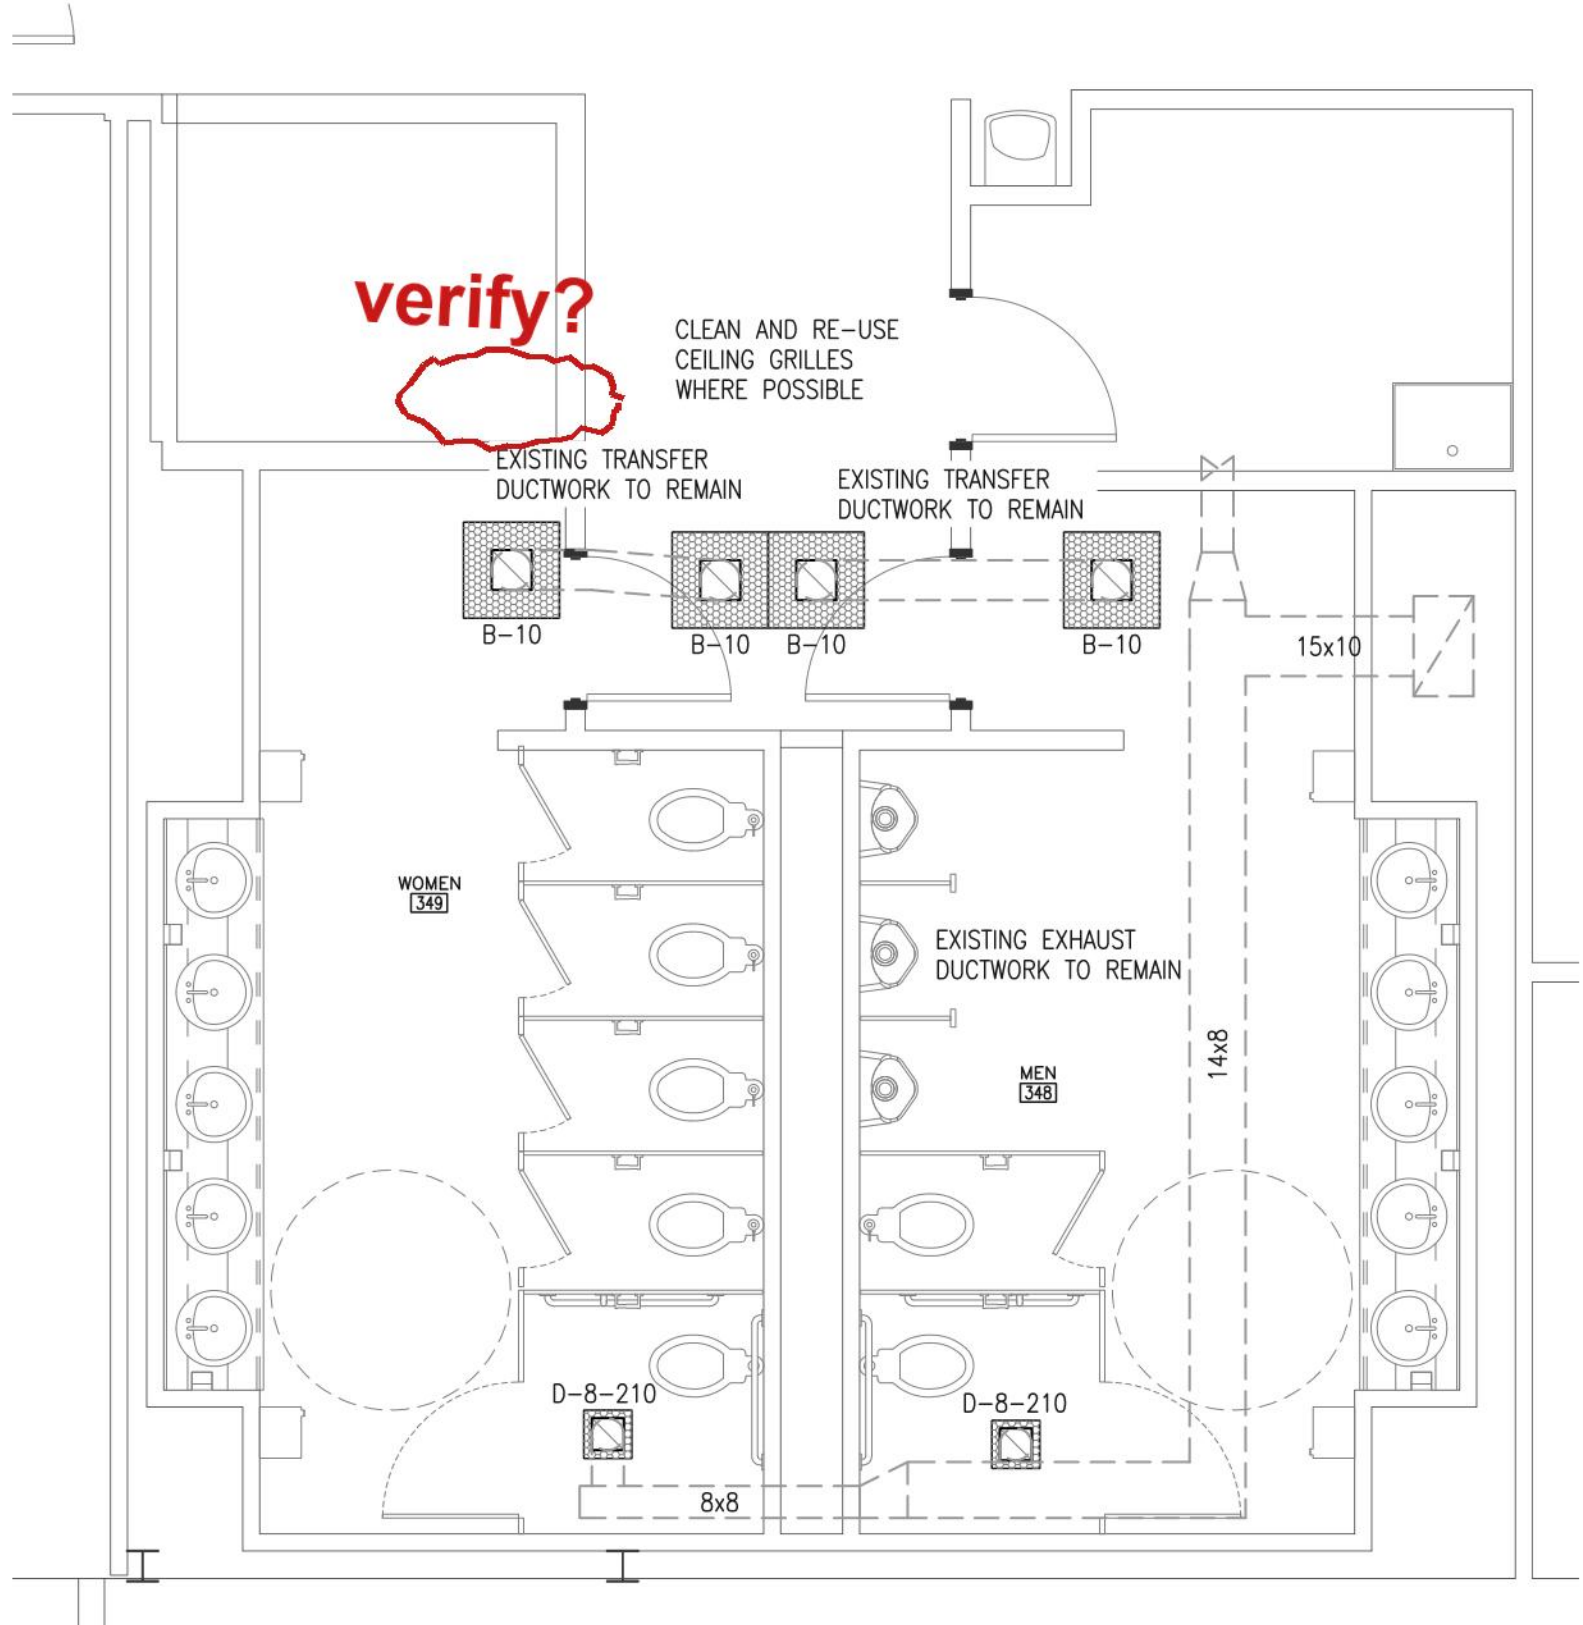

6 THIRD FLOOR GROUP TOILET ENLARGED HVAC RENOVATION PLAN
1/4" = 1'-0"

5 SECOND FLOOR GROUP TOILET ENLARGED HVAC RENOVATION PLAN
1/4" = 1'-0"

4 FIRST FLOOR GROUP TOILET ENLARGED HVAC RENOVATION PLAN
1/4" = 1'-0"



MIDLANDS
TECHNICAL COLLEGE
ACADEMIC CENTER
BATHROOM
RENOVATIONS
AIRPORT CAMPUS

PROJECT TITLE

OSE # -H59-N178-CL



FELKEL & HASTINGS
Mechanical Engineers
2725 Cypress Street
Columbia, S.C. 29205
Comm. No.: 22-40a Date: 09-15-22

1. THIS DRAWING IS THE PROPERTY OF BOOMERANG DESIGN P.A. AND IS NOT TO BE REPRODUCED OR COPIED IN WHOLE OR IN PART. IT IS NOT TO BE USED ON ANY OTHER PROJECT AND IS TO BE RETURNED ON REQUEST.

2. MATERIALS, DIMENSIONS AND ALL OTHER CONDITIONS WHICH ARE NOT OTHERWISE DEFINED ON THIS DRAWING SHALL BE CONSIDERED AS HAVING THE SAME MEANING AS SIMILARLY INDICATED CONDITIONS WHICH ARE MORE FULLY DEFINED ELSEWHERE ON THIS PROJECT OR OTHER DRAWINGS OF THIS PROJECT.

3. DO NOT SCALE OFF DIMENSIONS.

REVISIONS

NO.	DATE	DESCRIPTION
-----	------	-------------

CD

PROJECT PHASE

2217

BOOMERANG DESIGN PROJECT NUMBER

9.23.2022

DRAWING RELEASE DATE

ENLARGED HVAC
TOILET ROOM
PLANS
SHEET TITLE

M101

SHEET