


REVIEW SET

REV. 1 - 8/30/23

W

E

S

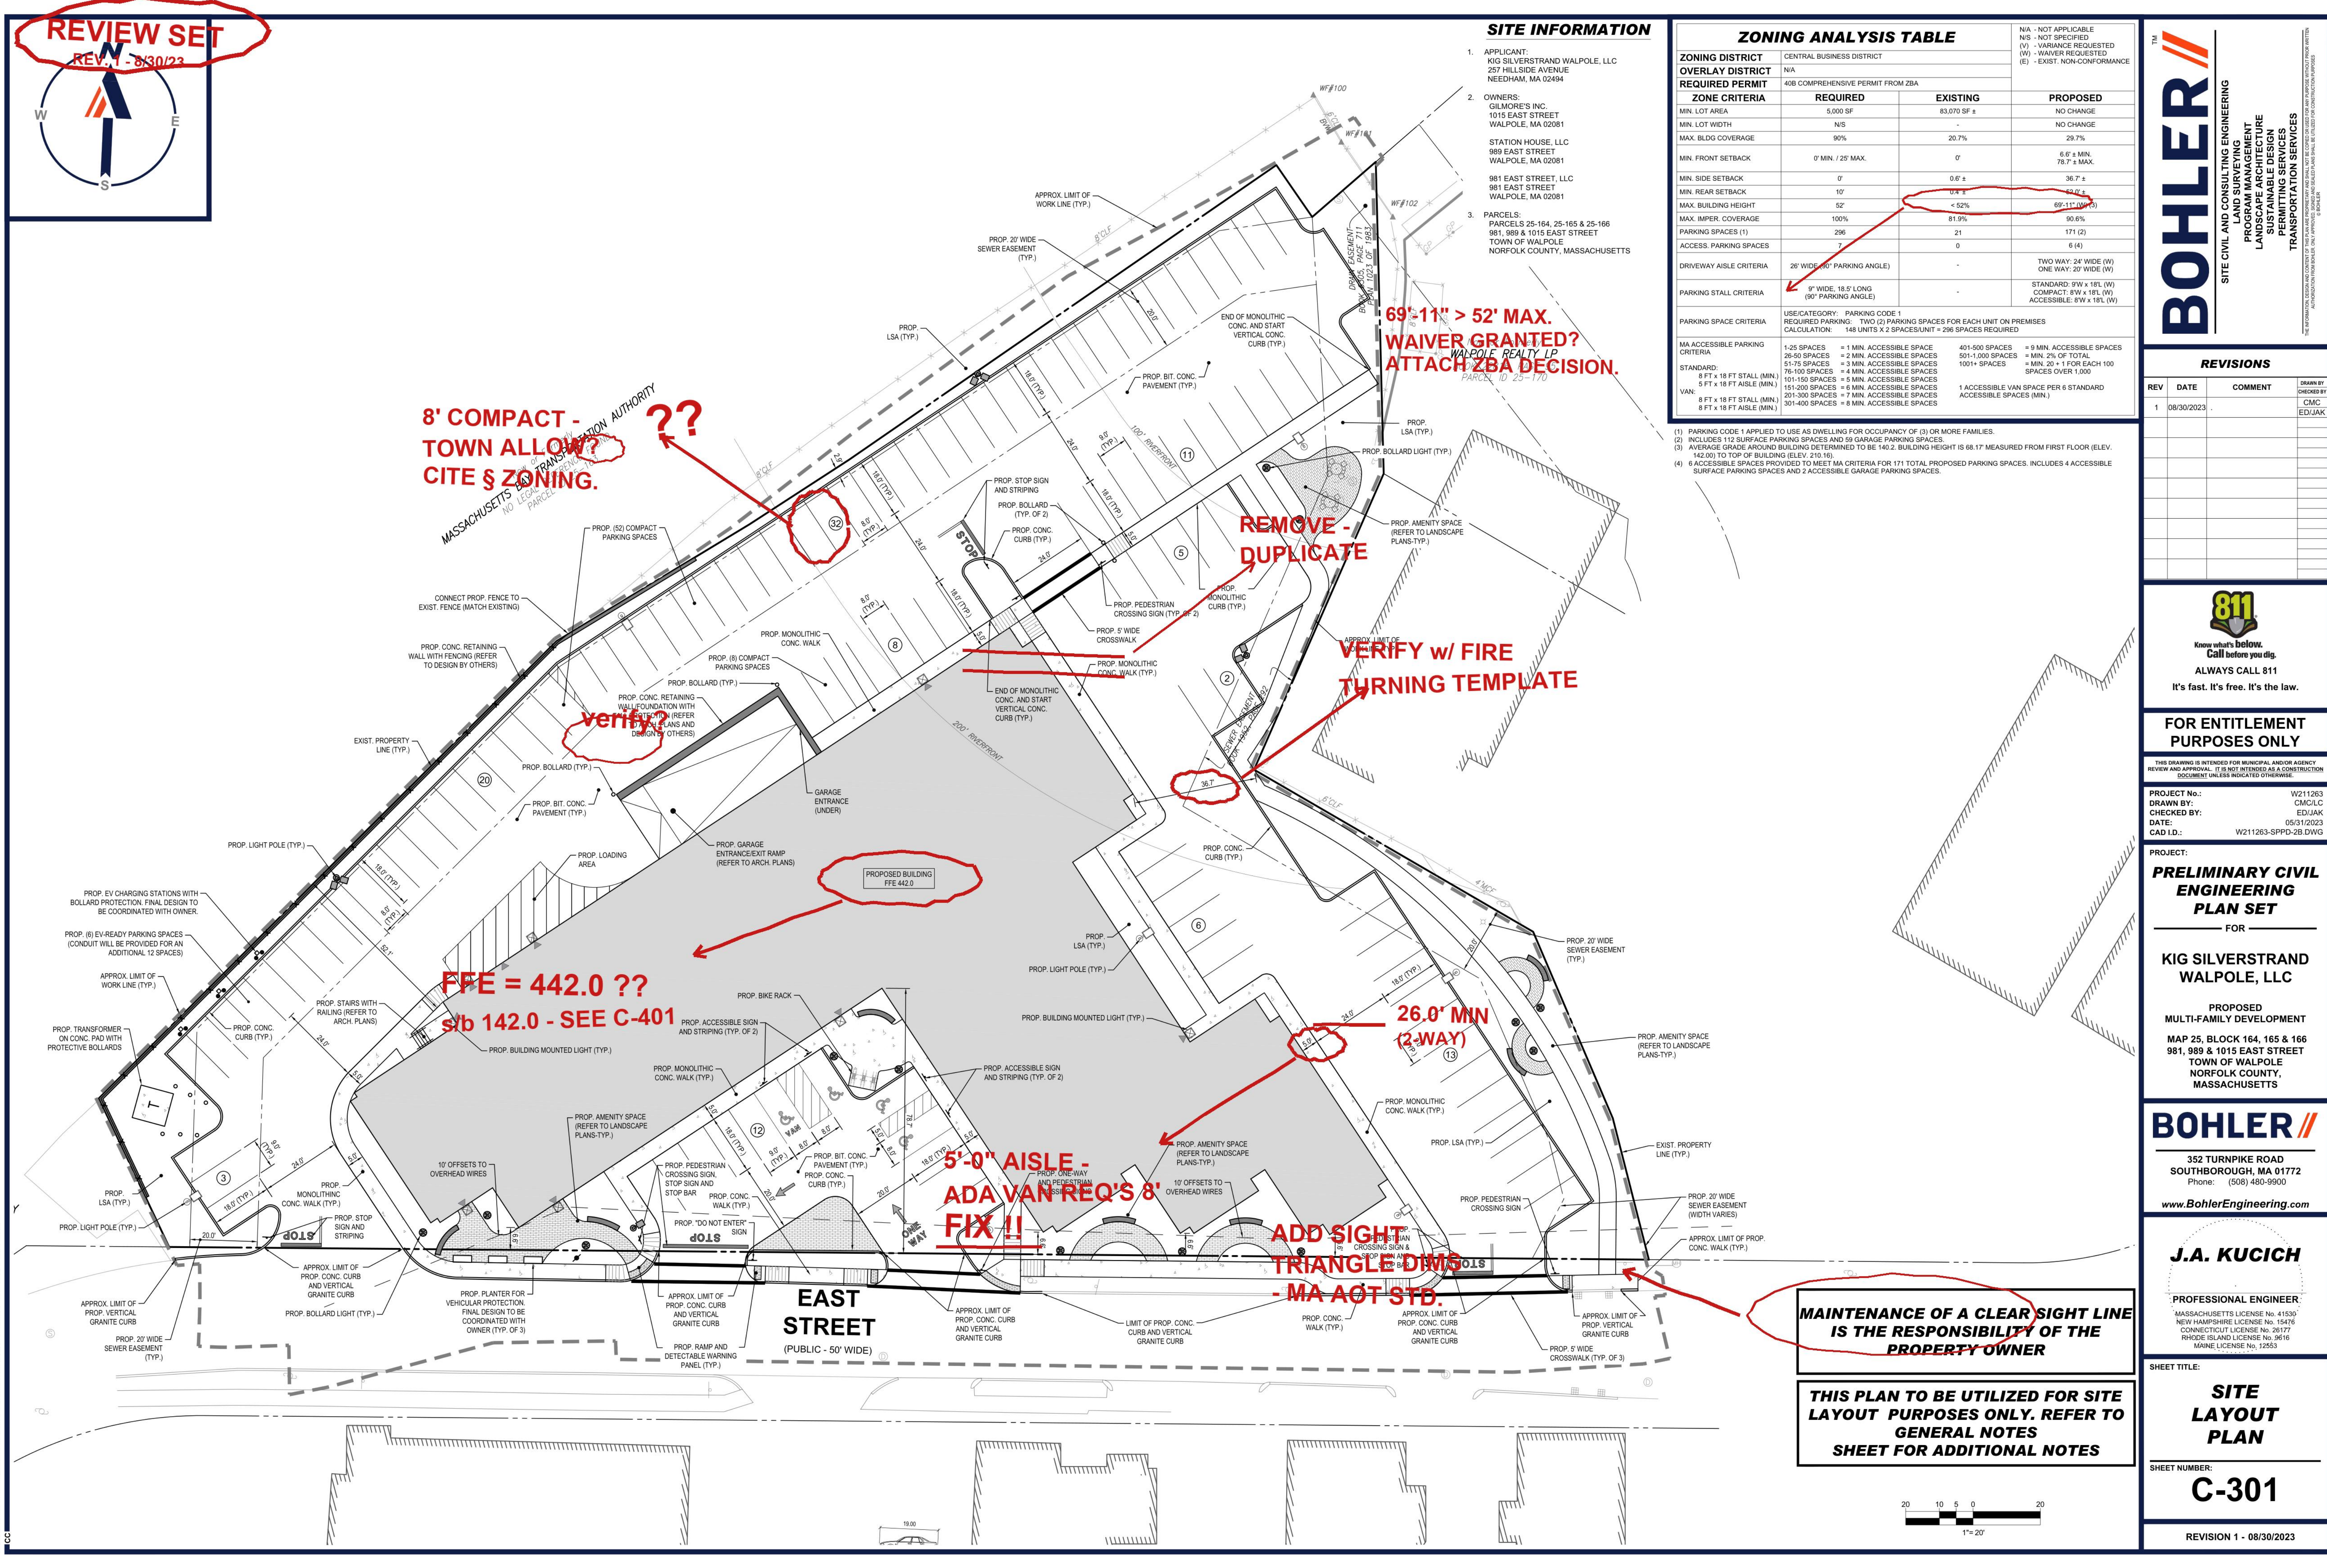

SITE INFORMATION

- APPLICANT:
KIG SILVERSTRAND WALPOLE, LLC
257 HILLSIDE AVENUE
NEEDHAM, MA 02494
- OWNERS:
GILMORE'S INC.
1015 EAST STREET
WALPOLE, MA 02081

STATION HOUSE, LLC
989 EAST STREET
WALPOLE, MA 02081

981 EAST STREET, LLC
981 EAST STREET
WALPOLE, MA 02081
- PARCELS:
25-164, 25-165 & 25-166
981, 989 & 1015 EAST STREET
TOWN OF WALPOLE
NORFOLK COUNTY, MASSACHUSETTS

ZONING ANALYSIS TABLE

ZONING ANALYSIS TABLE			
ZONING DISTRICT	CENTRAL BUSINESS DISTRICT		
OVERLAY DISTRICT	N/A		
REQUIRED PERMIT	40B COMPREHENSIVE PERMIT FROM ZBA		
ZONE CRITERIA	REQUIRED	EXISTING	PROPOSED
MIN. LOT AREA	5,000 SF	83,070 SF ±	NO CHANGE
MIN. LOT WIDTH	N/S	-	NO CHANGE
MAX. BLDG COVERAGE	90%	20.7%	29.7%
MIN. FRONT SETBACK	0' MIN. / 25' MAX.	0'	6.6' ± MIN. 78.7' ± MAX.
MIN. SIDE SETBACK	0'	0.6' ±	36.7' ±
MIN. REAR SETBACK	10'	0.4' ±	62.4' ±
MAX. BUILDING HEIGHT	52'	< 52%	69'-11" (W/3)
MAX. IMPER. COVERAGE	100%	81.9%	90.6%
PARKING SPACES (1)	296	21	171 (2)
ACCESS. PARKING SPACES	1	0	6 (4)
DRIVEWAY AISLE CRITERIA	26' WIDE (90° PARKING ANGLE)	-	TWO WAY: 24' WIDE (W) ONE WAY: 20' WIDE (W)
PARKING STALL CRITERIA	9' WIDE, 18.5' LONG (90° PARKING ANGLE)	-	STANDARD: 9'W x 18'L (W) COMPACT: 8'W x 18'L (W) ACCESSIBLE: 8'W x 18'L (W)
PARKING SPACE CRITERIA	USE/CATEGORY: PARKING CODE 1 REQUIRED PARKING: TWO (2) PARKING SPACES FOR EACH UNIT ON PREMISES CALCULATION: 148 UNITS X 2 SPACES/UNIT = 296 SPACES REQUIRED		
MA ACCESSIBLE PARKING CRITERIA	1-25 SPACES = 1 MIN. ACCESSIBLE SPACE 26-50 SPACES = 2 MIN. ACCESSIBLE SPACES 51-75 SPACES = 3 MIN. ACCESSIBLE SPACES 76-100 SPACES = 4 MIN. ACCESSIBLE SPACES 101-150 SPACES = 5 MIN. ACCESSIBLE SPACES 151-200 SPACES = 6 MIN. ACCESSIBLE SPACES 201-300 SPACES = 7 MIN. ACCESSIBLE SPACES 301-400 SPACES = 8 MIN. ACCESSIBLE SPACES	401-500 SPACES = 9 MIN. ACCESSIBLE SPACES 501-1,000 SPACES = MIN. 2% OF TOTAL 1001+ SPACES = MIN. 20 + 1 FOR EACH 100 SPACES OVER 1,000	1 ACCESSIBLE VAN SPACE PER 6 STANDARD ACCESSIBLE SPACES (MIN.)

(1) PARKING CODE 1 APPLIED TO USE AS DWELLING FOR OCCUPANCY OF (3) OR MORE FAMILIES.
(2) INCLUDES 112 SURFACE PARKING SPACES AND 59 GARAGE PARKING SPACES.
(3) AVERAGE GRADE AROUND BUILDING DETERMINED TO BE 140.2. BUILDING HEIGHT IS 68.17' MEASURED FROM FIRST FLOOR (ELEV. 142.00) TO TOP OF BUILDING (ELEV. 210.18).
(4) 6 ACCESSIBLE SPACES PROVIDED TO MEET MA CRITERIA FOR 171 TOTAL PROPOSED PARKING SPACES. INCLUDES 4 ACCESSIBLE SURFACE PARKING SPACES AND 2 ACCESSIBLE GARAGE PARKING SPACES.

BOHLER

SITE CIVIL AND CONSULTING ENGINEERING
PROGRAM MANAGEMENT
LANDSCAPE ARCHITECTURE
SUSTAINABLE DESIGN
PERMITTING SERVICES
TRANSPORTATION SERVICES

REVISIONS			
REV	DATE	COMMENT	CHECKED BY
1	08/30/2023		CMC ED/JAK

811

Know what's below.
Call before you dig.
ALWAYS CALL 811
It's fast. It's free. It's the law.

FOR ENTITLEMENT PURPOSES ONLY

THIS DRAWING IS INTENDED FOR MUNICIPAL AND/OR AGENCY REVIEW AND APPROVAL. IT IS NOT INTENDED AS A CONSTRUCTION DOCUMENT UNLESS INDICATED OTHERWISE.

PROJECT No.: W211263
DRAWN BY: CMC/LC
CHECKED BY: ED/JAK
DATE: 05/11/2023
CAD ID: W211263-SPPD-2B DWG

PROJECT:

PRELIMINARY CIVIL ENGINEERING PLAN SET

FOR KIG SILVERSTRAND WALPOLE, LLC

PROPOSED MULTI-FAMILY DEVELOPMENT
MAP 25, BLOCK 164, 165 & 166
981, 989 & 1015 EAST STREET
TOWN OF WALPOLE
NORFOLK COUNTY, MASSACHUSETTS

BOHLER

352 TURNPIKE ROAD
SOUTHBOROUGH, MA 01772
Phone: (508) 480-9900
www.BohlerEngineering.com

J.A. KUCICH

PROFESSIONAL ENGINEER
MASSACHUSETTS LICENSE No. 41530
NEW HAMPSHIRE LICENSE No. 15476
CONNECTICUT LICENSE No. 26177
RHODE ISLAND LICENSE No. 3616
MAINE LICENSE No. 12553

SHEET TITLE:

SITE LAYOUT PLAN

SHEET NUMBER:

C-301

REVISION 1 - 08/30/2023