


ROOF FRAMING PLAN NOTES:

1. BOTTOM OF STEEL DECK ELEVATION VARIES AND IS NOTED ON PLANS THUS XX'-X" U.N.O.
2. ROOF DECK SHALL BE 3" x 18 GA. VERO TYPE N DECK OR EQUAL. DECK SHALL SPAN CONTINUOUS OVER 3 OR MORE SPANS (4 SUPPORTS). SEE ARCHITECTURAL DRAWINGS FOR INSULATION, ROOFING ETC. WELD DECK USING 1/2" DIA. NET EFFECTIVE PUDDLE WELDS AS FOLLOWS:
 - A. PERPENDICULAR BEARINGS: 4 WELDS PER SHEET PER SUPPORT
 - B. PARALLEL EDGES: AT 12" O.C.
 - C. SIDE SEAMS: BUTTON PUNCH AT 12" O.C.
3. DO NOT HANG LOADS EXCEEDING 150 LBS FROM METAL DECK. PROVIDE ENGINEERED STRUCTURAL SYSTEM TO HANG ALL LOADS EXCEEDING 150 LBS FROM STEEL JOISTS OR BEAMS. THIS INCLUDES BUT IS NOT LIMITED TO METAL STUD SOFFIT OR CEILING FRAMING, MECHANICAL OR PLUMBING EQUIPMENT, ETC.
4. FOR TYPICAL BEAM TO BEAM AND BEAM TO COLUMN CONNECTIONS SEE 1/S5.02.
5. FOR TYPICAL DETAILS SEE SHEET S5.02. FOR GENERAL NOTES SEE SHEET S1.10.
6. SEE ARCHITECTURAL DRAWINGS TO VERIFY ROOF SLOPES, ROOF DRAINS, PENETRATIONS, ETC.
7. THESE DRAWINGS ARE BASED ON EXISTING AS BUILT STRUCTURAL DRAWINGS BY GB&L CONSULTING ENGINEERS DATED AUGUST 18, 1989.
8. FOR SEISMIC BRACING OF EXHAUST HOODS, SEE DETAILS 13 AND 14 ON SHEET S5.02.
9. FOR COLD FORMED STEEL DETAILS, SEE SHEET S5.03.
10. UNISTRUT MEMBERS SUPPORTING CEILING SOFFITS ARE NOT SHOWN FOR CLARITY. SEE DETAIL 10 ON SHEET S5.02 AND DETAILS 11 AND 12 ON SHEET S5.03.

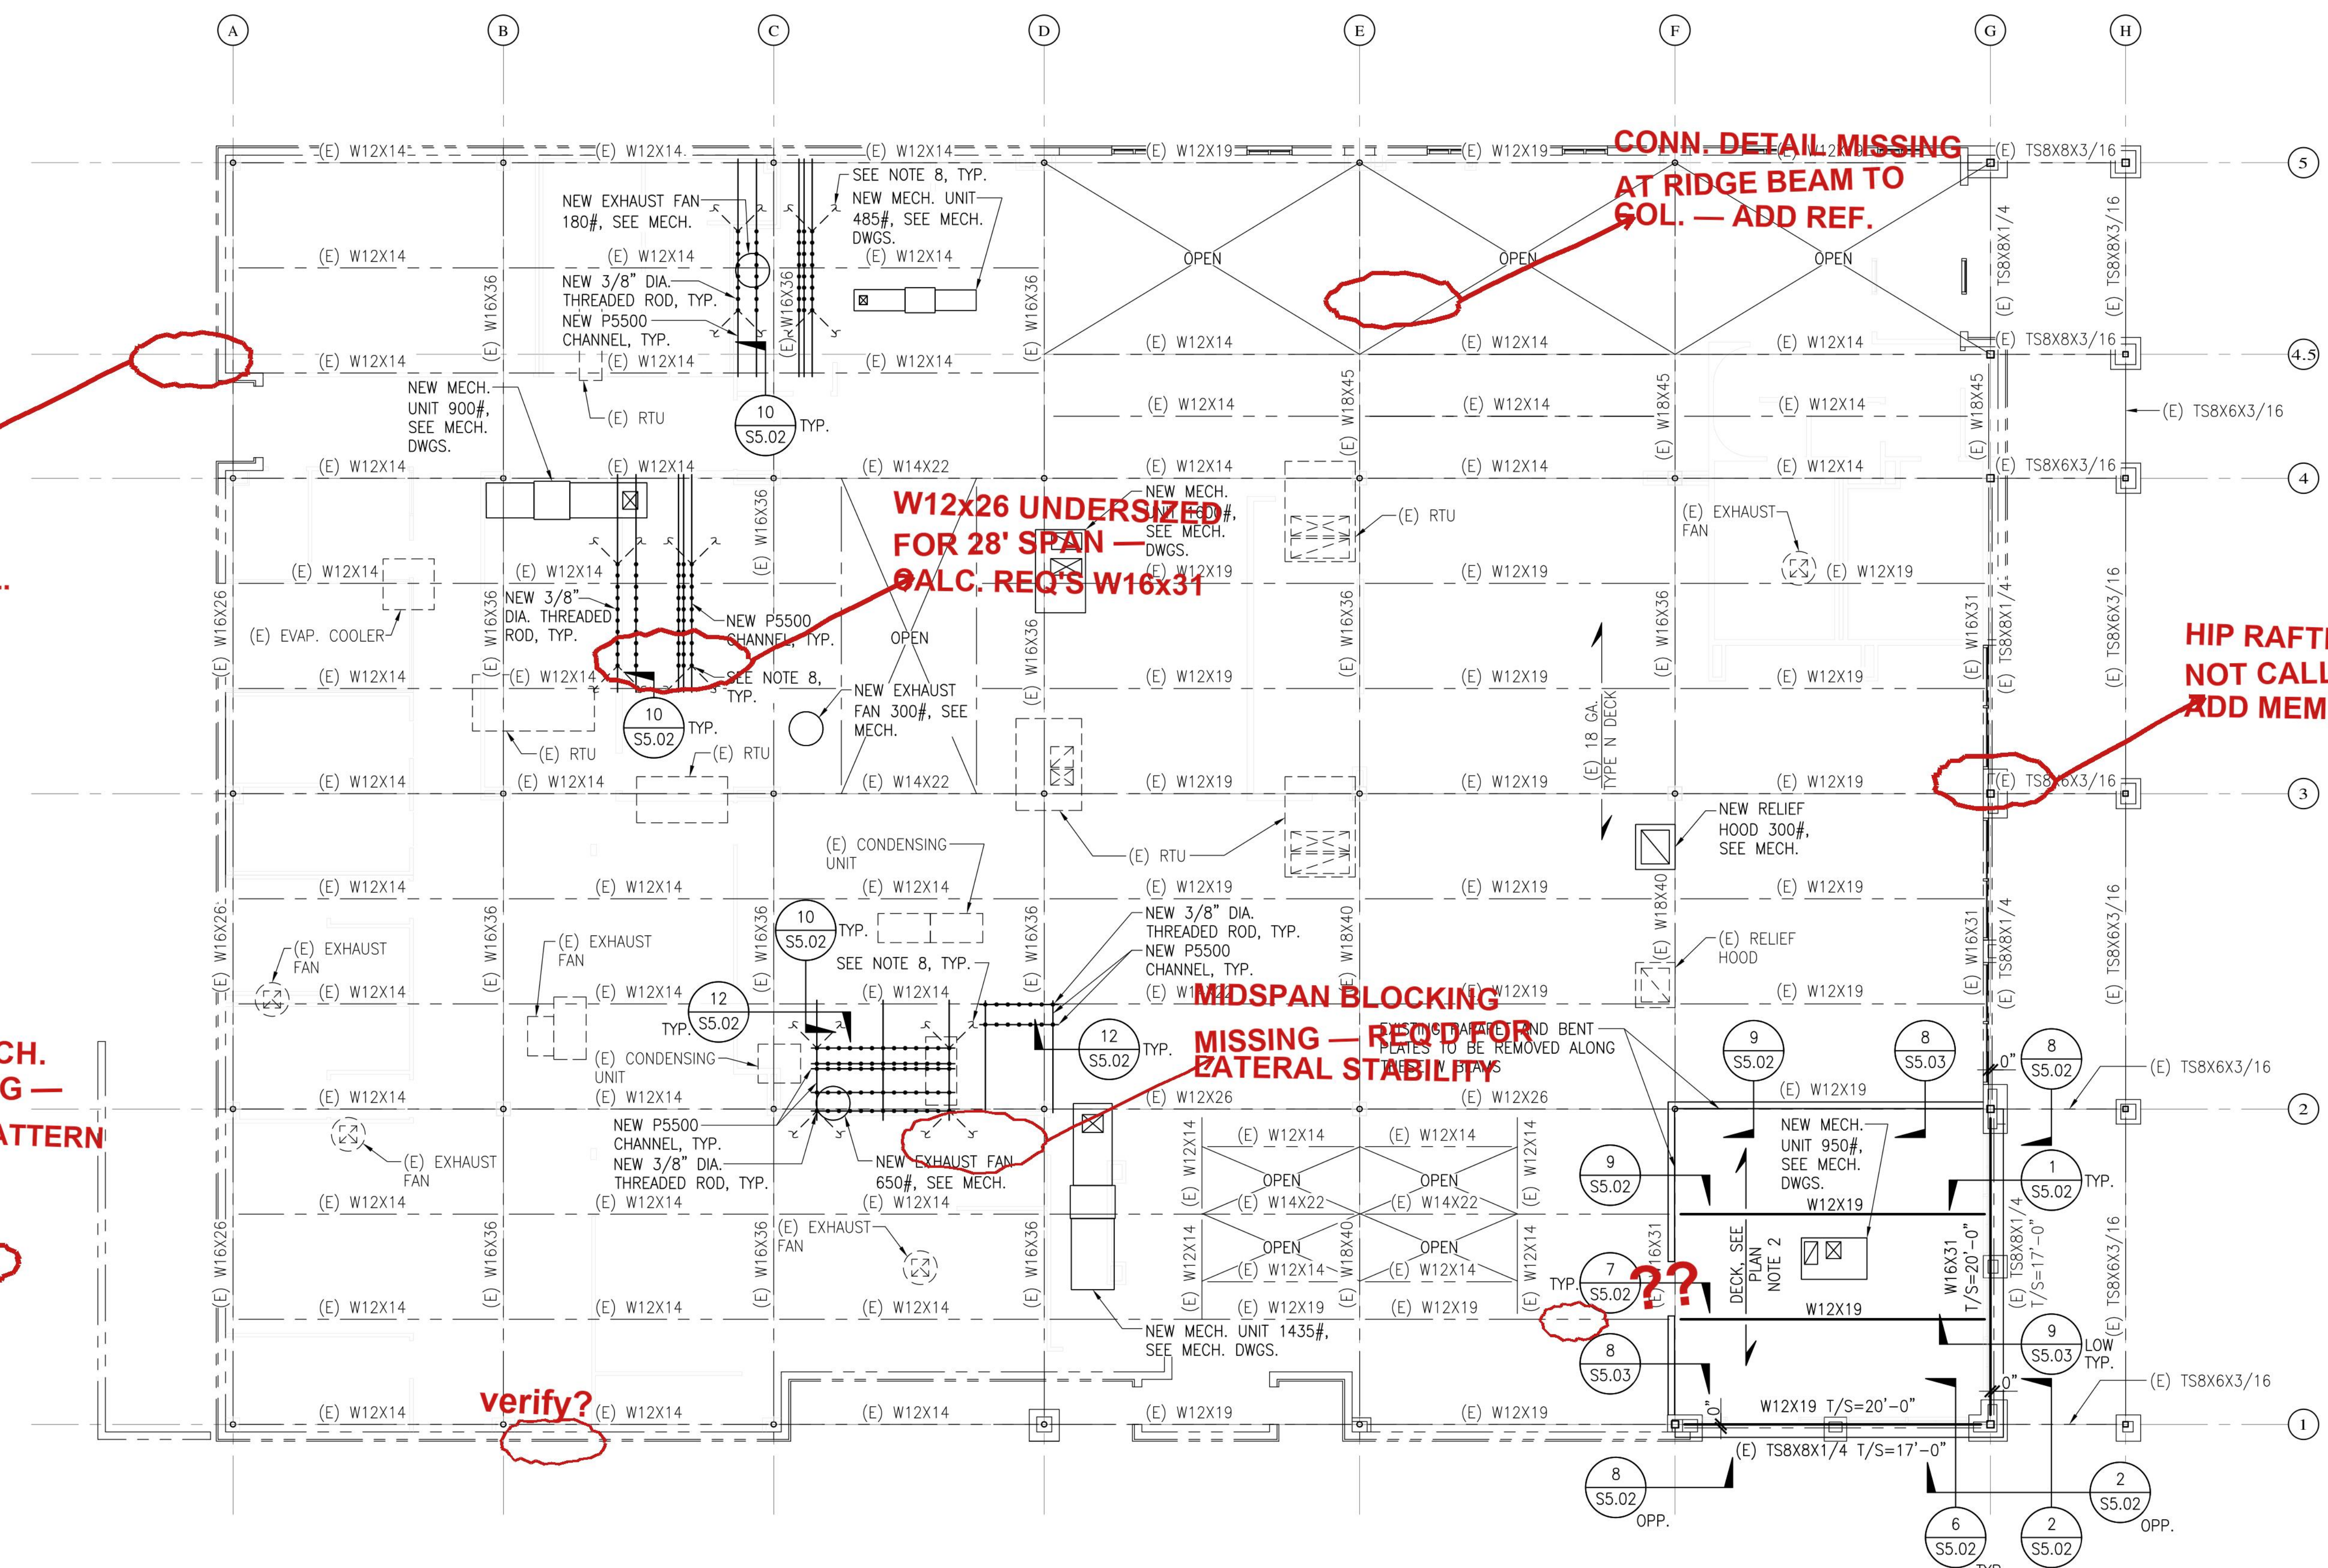

ROOF FRAMING PLAN
1/8" = 1'-0"