

REVIEW SET


REV. 1 - 8/30/23

W

E

S

THIS PLAN TO BE UTILIZED FOR UTILITIES PURPOSES ONLY. REFER TO GENERAL NOTES SHEET FOR ADDITIONAL GRADING & UTILITY NOTES

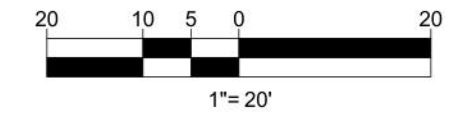

BOHLER

SITE CIVIL AND CONSULTING ENGINEERING
PROJECT MANAGEMENT
LANDSCAPE ARCHITECTURE
SUSTAINABLE DESIGN
PERMITTING SERVICES
TRANSPORTATION SERVICES

REVISIONS				
REV	DATE	COMMENT	DRAWN BY	
1	08/30/2023		CMC	ED/JAK

811

Know what's below.
Call before you dig.
ALWAYS CALL 811
It's fast. It's free. It's the law.

FOR ENTITLEMENT PURPOSES ONLY

THIS DRAWING IS INTENDED FOR MUNICIPAL AND/OR AGENCY REVIEW AND APPROVAL. IT IS NOT INTENDED AS A CONSTRUCTION DOCUMENT UNLESS INDICATED OTHERWISE.

PROJECT No.: W211263
DRAWN BY: CMC/LC
CHECKED BY: ED/JAK
DATE: 05/31/2023
CAD ID: W211263-SPPD-2B.DWG

PROJECT:
PRELIMINARY CIVIL ENGINEERING PLAN SET
FOR
KIG SILVERSTRAND WALPOLE, LLC
PROPOSED MULTI-FAMILY DEVELOPMENT
MAP 25, BLOCK 164, 165 & 166
981, 989 & 1015 EAST STREET
TOWN OF WALPOLE
NORFOLK COUNTY,
MASSACHUSETTS


BOHLER

352 TURNPIKE ROAD
SOUTHBOROUGH, MA 01772
Phone: (508) 480-9900
www.BohlerEngineering.com

J.A. KUCICH

PROFESSIONAL ENGINEER
MASSACHUSETTS LICENSE No. 41530
NEW HAMPSHIRE LICENSE No. 15476
CONNECTICUT LICENSE No. 26177
RHODE ISLAND LICENSE No. 3616
MAINE LICENSE No. 12553

SHEET TITLE:
UTILITY PLAN
SHEET NUMBER:
C-501
REVISION 1 - 08/30/2023

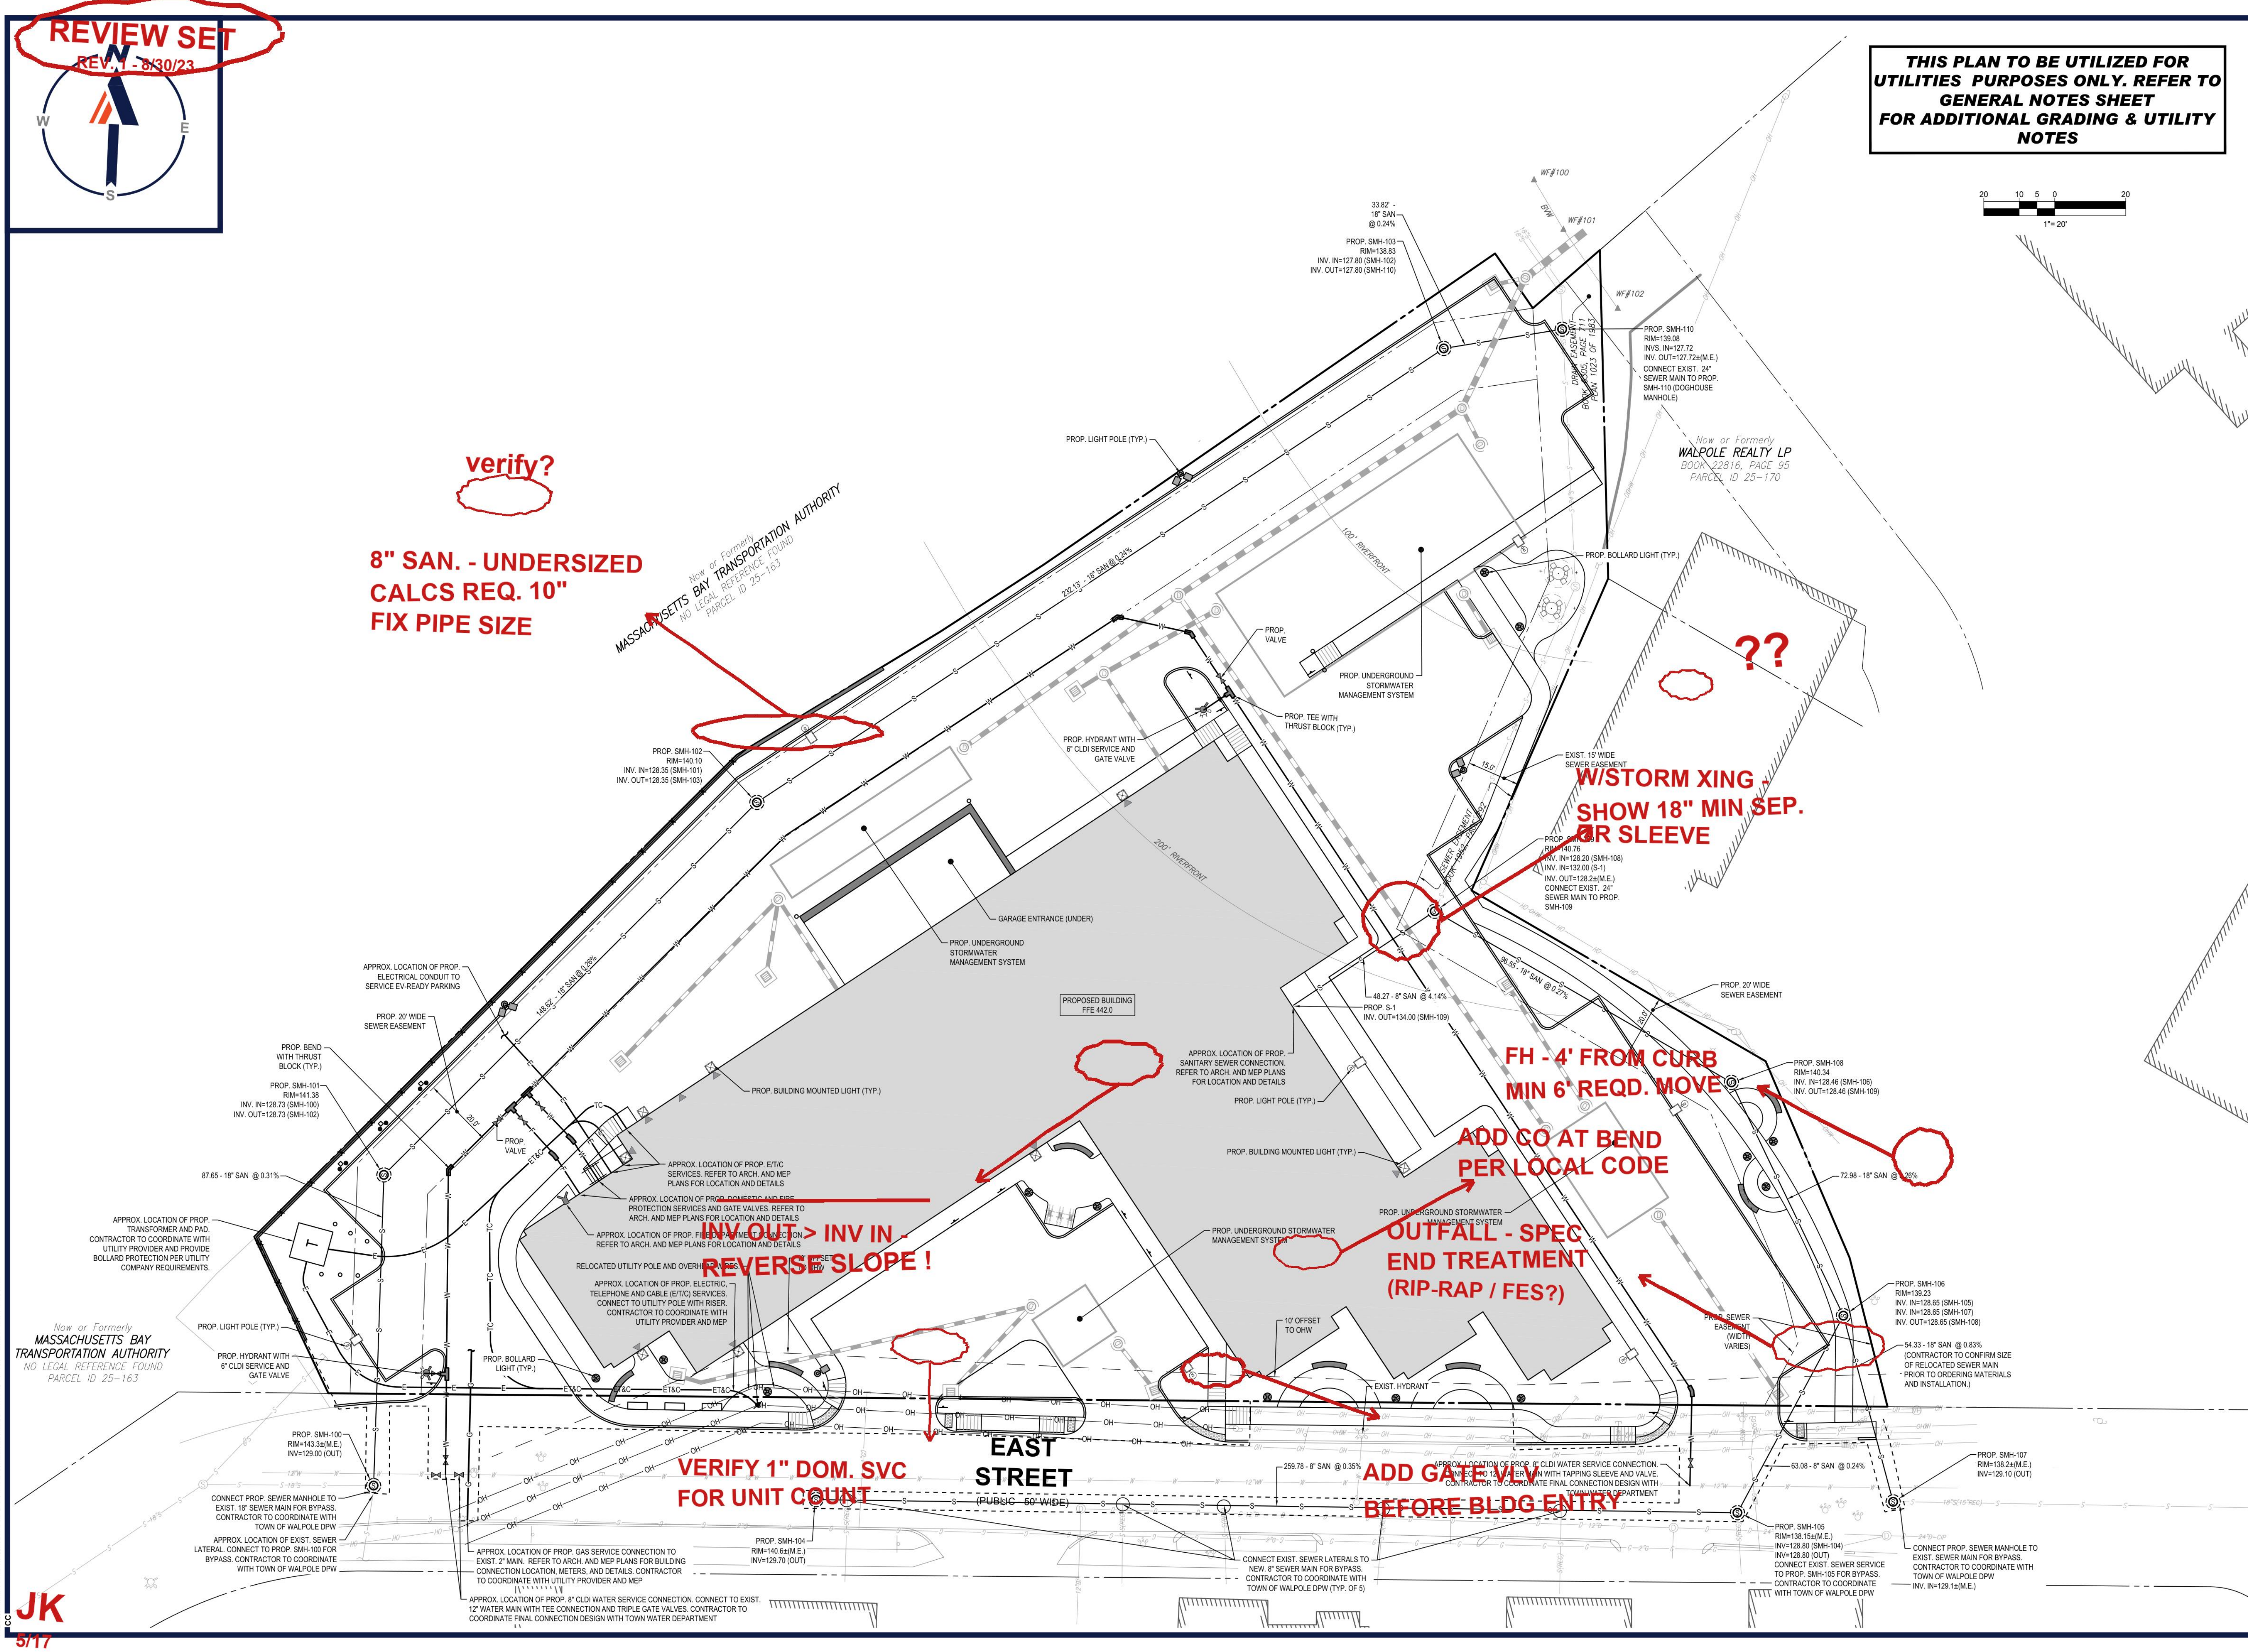

P:\11\W211263\CADD\DRAWINGS\PLAN SET\CIVIL SITE PLANS\W211263-SPPD-2B.dwg - LAYOUT: C-501-UTIL

JK
5/17